

Pearl River
 U 39
 11-7-69

MISSISSIPPI
 BOARD OF WATER COMMISSIONERS
 416 North State Street
 Jackson, Mississippi 39201

CODED
 CODED

WATER WELL DRILLERS LOG

11-7-1969 date well completed
 E.S. Water wells, Inc. firm name
 Pearl River county well located

LANDOWNER:

Bobby Joe Pester

description of formations encountered

from to

Rt. 1 Box 271 Carriere
 (mailing address) MISS.

~~0-20~~
 Red clay 0 20
 coarse white sd. 20 48
 white & blue clay 48 90
 Red fine sd. 90 110
 blue clay 110 138
 coarse fine sd. 138 175
 blue clay 175 231
 coarse sd. 231 308

WELL LOCATION:

sec. 10 T 5 N R 12 E
 2 miles W of Carriere
 (distance) (direction) (nearest town)

WELL PURPOSE: Home
 (home, irrigation, municipal, industrial)

WELL COMPLETION DATA:

- (1) diameter (inches) 4 1/2
- (2) total depth (feet) 308
- (3) static water level (feet) 102 below top of ground
- (4) casing 2" Galv 308 (material) (depth)
- 4" if telescope see back. (size)
- (5) screen 5 304-299 (length) (depth to top)
- 2 5.5 (size) (material)
- (6) pump 1 600 (HP) (yield gpm)
- Elect (type power)
- (7) electric log NO (yes or no)

(organization running log)

(8) how well bottom plugged shoe

DEC 18 1969

DRILLERS REMARKS:

MISS. BD. OF
 WATER COM. L.

If well telescopes please sketch and show depths.

GROUND LEVEL


102
Worfer
Level

4"

506
327
@ 125

126

299
screen
304

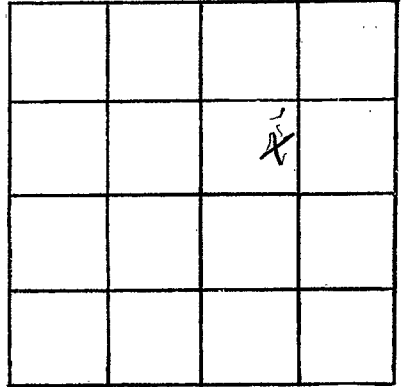

SECTION 10

Please indicate well location X.

ADDITIONAL INFORMATION

If more than one screen,
show locations of each on sketch.