

Pearl River
 U 40
 6-23-70

MISSISSIPPI
 BOARD OF WATER COMMISSIONERS
 416 North State Street
 Jackson, Mississippi 39201

CODED

WATER WELL DRILLERS LOG

6-23 1970 Neil Humphreys Pearl River
 date well completed firm name county well located

LANDOWNER: H.K. Smith Jr.
 Picayune, Miss.
 Route
 (mailing address)

description of formations encountered	from	to
Surface Clay	0	20
✓ sand	20	80

WELL LOCATION:
 sec. 35 T. 5 S. R. 17 E.
 2 miles N of Picayune
 (distance) (direction) (nearest town)

Blue clay	80	250
Good sand	250	300

WELL PURPOSE:
 (home, irrigation, municipal, industrial)

WELL COMPLETION DATA:

(1) diameter (inches) 2"
 (2) total depth (feet) 300'
 (3) static water level (feet) 60' below top of ground.
 (4) casing galv. (material) (depth) 2" (size) if telescope see back.
 (5) screen 5' (length) (depth to top) 2" St. Steel (size) (material)
 (6) pump 1 (HP) 150 gpm (yield) (gpm) electric (type power)
 (7) electric log no! (yes or no)
 (organization running log)
 (8) how well bottom plugged

CODED


JUN 26 1970

DRILLERS REMARKS: Johnson
 B.P. Valve

MISS. BD. OF
 WATER COMM.
 WATER COMM.

If well telescopes please sketch and show depths.

GROUND LEVEL

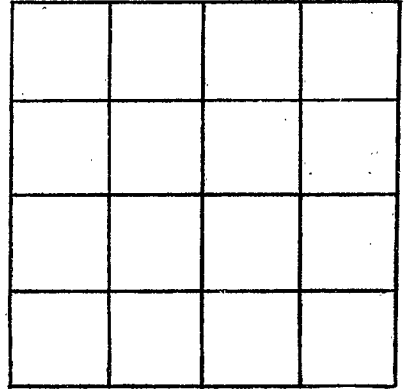

SECTION _____

Please indicate well location X.

ADDITIONAL INFORMATION

If more than one screen, show locations of each on sketch.