

PEARL RIVER
U 42
10-17-70

MISSISSIPPI
 BOARD OF WATER COMMISSIONERS
 416 North State Street
 Jackson, Mississippi 39201

CODED

WATER WELL DRILLERS LOG

10-17 1970 Pen-ton Well Serv Pearl River
 date well completed firm name county well located

LANDOWNER: Clelly Farmer
147 Hwy 11 S
Picayune Miss
 (mailing address)

description of formations encountered	from	to
Surface clay	0	16
Red sand	16	55
White clay	55	90
Blue clay	90	146
Sand	146	160
Blue clay	160	272
Sand	272	290

WELL LOCATION:
 sec. 26 T 5 S R. 17 E W
1 miles West of Ozona
 (distance) (direction) (nearest town)

WELL PURPOSE: Home
 (home, irrigation, municipal, industrial)

- WELL COMPLETION DATA: 4 1/2
- (1) diameter (inches) 2
 - (2) total depth (feet) 290
 - (3) static water level (feet) 60 below top of ground.
 - (4) casing Galv, 285
 (material) (depth)
2" If telescope see back.
 (size)
 - (5) screen 5, 285
 (length) (depth to top)
2", S. Steel
 (size) (material)
 - (6) pump 1 11
 (HP) (yield gpm)
Elec
 (type power)
 - (7) electric log No
 (yes or no)
 (organization running log)
 - (8) how well bottom plugged B.W. Valve

CODED


NOV 20 1970

DRILLERS REMARKS:

MISS. BD OF
 WATER COMM.

If well telescopes please sketch and show depths.

GROUND LEVEL

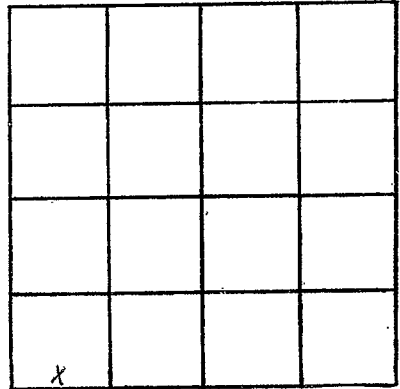

SECTION 26

Please indicate well location X.

ADDITIONAL INFORMATION

If more than one screen, show locations of each on sketch.