

PEARL RIVER
U45
3-6-71

MISSISSIPPI
BOARD OF WATER COMMISSIONERS
416 North State Street
Jackson, Mississippi 39201

CODED

WATER WELL DRILLERS LOG

3-6 1971 Penton Well Serv Pearl River
date well completed firm name county well located

LANDOWNER: Boyd Taylor
Rt 2 Box 225
Picayune Miss
(mailing address)

description of formations encountered	from	to
Surface Clay	0	12
Sand	12	50
Blue Clay	50	95
Sand	95	115
Blue Clay	115	270
Sand	270	330
Blue Clay	330	380
Sand	380	435
Blue Clay	435	500
Sand	500	530
Blue Clay	530	563
Sand	563	630
Blue Clay	630	680
Sand	680	725
Blue Clay	725	935
Sand	935	984

WELL LOCATION:
sec. 34 T 5 N R 17 E
S W
2 miles north of Picayune
(distance) (direction) (nearest town)

WELL PURPOSE: Home
(home, irrigation, municipal, industrial)

WELL COMPLETION DATA: 4 1/2

(1) diameter (inches) 2

(2) total depth (feet) 984

(3) static water level (feet) Flow ^{below} above top of ground.

(4) casing Galv 964
(material) (depth)

2 if telescope see back.
(size)

(5) screen 20 964
(length) (depth to top)

2 S. Steel
(size) (material)

(6) pump ✓ ✓
(HP) (yield gpm)

(type power)

(7) electric log No
(yes or no)

(organization running log)

(8) how well bottom plugged Bo Valve

CODED


APR - 7 1971

MISS. BD. OF
WATER COMM.

DRILLERS REMARKS: 23 lbs
Pressure

If well telescopes please sketch and show depths.

GROUND LEVEL

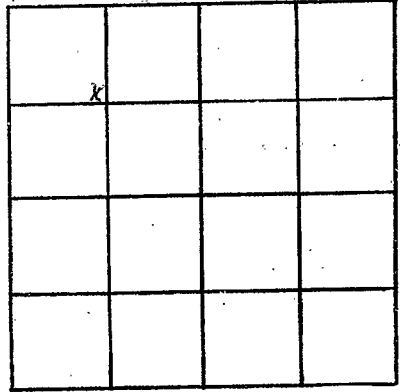

SECTION 34

Please indicate well location X.

ADDITIONAL INFORMATION

If more than one screen,
show locations of each on sketch.