

U-46
12-21-62

WATER WELL DRILLERS LOG

Date: Dec 21 1962, Driller: POOPART
335-37 534-29 (Name)

Pearl River
County

CODED

- (1) Owner of Land: JACO
(Name)
Route 1 CARRIERE
(Address)
- (2) Location: 1/4, 1/4, Sec. 23 5 12
T O R E
4 miles West of CARRIERE
(distance) (direction) (Nearest Town)
- (3) Topography: (Hilly) (Flat) (Level)
- (4) Purpose of Well: DOMESTIC
(Domestic Irrigation
Municipal, Industrial, Other)

Description & Color of Materials Sand, Clay, Red Clay, Shell, etc.	Thick-ness Feet	Depth Feet
Ground + Red Clay	-	20
sand gravel clay	40	60
Blue Clay	105	165
Grey SAND	32	207


Information upon completion of well:

- (1) Diameter 2 inches.
- (2) Total Depth 206 feet.
- (3) Water Level 80 feet below top of ground.
- (4) Cased to _____, Size _____
- (5) Screen: Size 008, Length 6'
- (6) Were any formations sealed against pollution?
_____ yes, _____ no.

If YES depth of formation _____

Drillers Remarks: Set in small Rocks

CODED

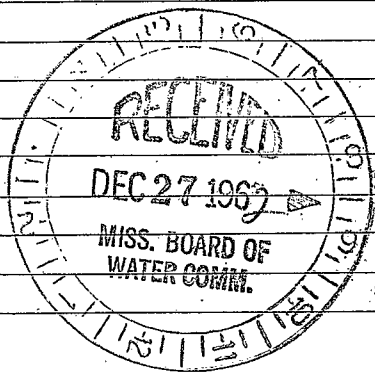

(Use Back Side)

Well No.

1944

1944

