

DU-49

8-17-65

WATER WELL DRILLERS LOG

Date: 8-17-, 1965, Driller: Neil Lumpkin **CODED**
 (Name)

(1) Owner of Land: Pilousi Harriel
 (Name)
Stepholico
 (Address) 22 4 14
33 T. 5 R 17
 (2) Location: 1/4, 1/4, Sec. 33, T. 5 R 17
17 miles South of Poplarville
 (distance) (direction) (Nearest Town)
 (3) Topography: Hilly
 (Hilly) (Flat) (Level)
 (4) Purpose of Well: Domestic
 (Domestic Irrigation
 Municipal, Industrial, Other)


Description & Color of Materials Sand, Clay, Red Clay, Shell, etc.	Thick- ness Feet	Depth Feet
<u>Surface Clay</u>	<u>0</u>	<u>10</u>
<u>" Sand - no good -</u>	<u>10</u>	<u>45</u>
<u>Blue Clay</u>	<u>45</u>	<u>250</u>
<u>Good Sand</u>	<u>250</u>	<u>294</u>

Information upon completion of well:

(1) Diameter 2 inches.
 (2) Total Depth 294 feet.
 (3) Water Level 126 feet below top of ground.
 (4) Cased to _____, Size _____,
 (5) Screen: Size 2", Length 5'
 (6) Were any formations sealed against pollution?
 _____ yes, no no.

CODED

If YES depth of formation _____
 Why _____
 Drillers Remarks: _____

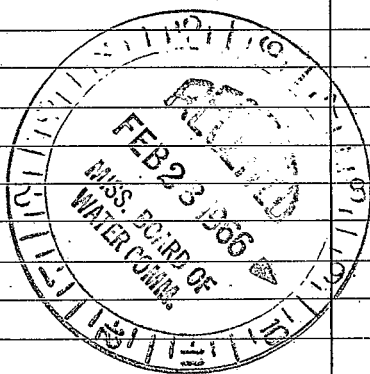

(Use Back Side)

Well No.

