

Pearl R.

MISSISSIPPI BOARD OF WATER COMMISSIONERS

U-50

10-29-65

WATER WELL DRILLERS LOG

**CODED**

Date: 10-29, 1965, Driller: Walter Pentoni County Pearl River

(Name)

(1) Owner of Land: Lee L. Pentoni  
(Name)

Rt 2 OZONA  
(Address)

(2) Location: 1/4, 1/4, Sec. 25 T 5 R 17

0 miles 0 of OZONA  
(distance) (direction) (Nearest Town)

(3) Topography: Hilly  
(Hilly) (Flat) (Level)

(4) Purpose of Well: Domestic  
(Domestic Irrigation  
Municipal, Industrial, Other)

Description & Color of Materials  
Sand, Clay, Red Clay, Shell, etc.

Thick-  
ness  
Feet

Depth  
Feet

Red clay	18	0-18
" Mud	13	31
White sand	33	64
Yellow clay	25	89
Sand	58	147
Blue clay	48	195
Sand	23	218
Blue clay	19	237
<del>Sand</del>	<del>41</del>	<del>278</del>
Sand	141	378
Blue clay	282	660
Sand	54	714

Information upon completion of well:

(1) Diameter 2 inches.

(2) Total Depth 709 feet.

(3) Water Level -26 feet below top of ground.

(4) Cased to \_\_\_\_\_, Size \_\_\_\_\_

(5) Screen: Size .012, Length 10'


(6) Were any formations sealed against pollution?  
\_\_\_\_\_ yes, \_\_\_\_\_ no.

If YES depth of formation \_\_\_\_\_

Why \_\_\_\_\_

Drillers Remarks: \_\_\_\_\_

**CODED**

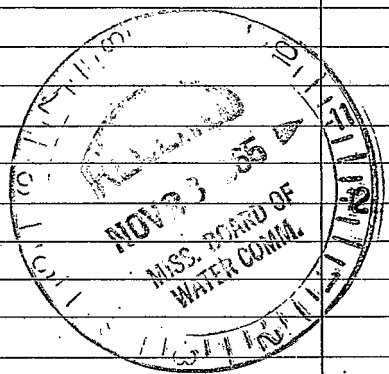

(Use Back Side)

Well No.

