

Pearl R.
U-51
1-19-66

MISSISSIPPI BOARD OF WATER COMMISSIONERS

WATER WELL DRILLERS LOG

CODED

Date: 1-19, 1966, Driller: Neil Lumpkin County P. R.
(Name)

(1) Owner of Land: Morris Hanners
(Name)
Carriere Route
(Address)

(2) Location: 1/4, 1/4, Sec. 34 T5 R17
3 miles South of Carriere
(distance) (direction) (Nearest Town)

(3) Topography: Flat
(Hilly) (Flat) (Level)

(4) Purpose of Well: Domestic
(Domestic Irrigation
Municipal, Industrial, Other)

Description & Color of Materials Sand, Clay, Red Clay, Shell, etc.	Thick- ness Feet	Depth Feet
<u>Surface clay</u>	<u>0</u>	<u>10</u>
<u>" sand</u>	<u>10</u>	<u>105</u>
<u>Blue Clay</u>	<u>105</u>	<u>180</u>
<u>good sand</u>	<u>180</u>	<u>216</u>

Information upon completion of well:

(1) Diameter 2 inches.

(2) Total Depth 216 feet.


(3) Water Level 75 feet below top of ground.

(4) Cased to _____, Size _____

(5) Screen: Size 2", Length 5'

(6) Were any formations sealed against pollution?
_____ yes, No. no.

CODED

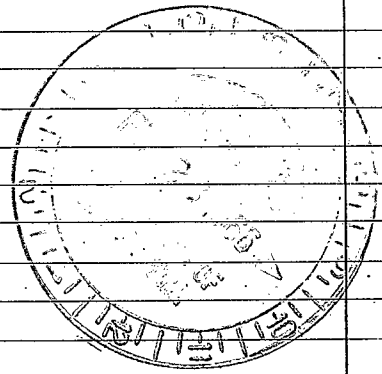

If YES depth of formation _____

Why _____

Drillers Remarks: _____

(Use Back Side)

Well No.

