

PEARL River
 U 55
 8-2-71

MISSISSIPPI
 BOARD OF WATER COMMISSIONERS
 416 North State Street
 Jackson, Mississippi 39201

WATER WELL DRILLERS LOG

8-2-71 date well completed 1971 ~~WILL~~ LUMPKIN WELL DRILLING SERVICE ~~PEARL RIVER~~ firm name MISS. county well located

CODED

LANDOWNER: P. E. Bullens
Carriere, Miss.
Route
 (mailing address)

description of formations encountered	from	to
surface clay	0	20
" sand	20	80

WELL LOCATION:
 sec. 26 T. 5 S. R. 17 W.
2 miles NW of Picayune
 (distance) (direction) (nearest town)

Blue clay	80	140
Good sand	140	195

WELL PURPOSE: home
 (home, irrigation, municipal, industrial)

- WELL COMPLETION DATA:
- (1) diameter (inches) 2"
 - (2) total depth (feet) 195
 - (3) static water level (feet) 40 below above top of ground.
 - (4) casing galv. (material) (depth)
2" if telescope see back.
 (size)
 - (5) screen 5' (length) (depth to top)
2" St. Steel (size) (material)
 - (6) pump 1/2 (HP) (yield gpm)
electric (type power)
 - (7) electric log No. (yes or no)

CODED

(organization running log)
 (8) how well bottom plugged Johnson
back pressure valve


OCT 11 1971

DRILLERS REMARKS:

MISS. BD. OF
 WATER COMM.

If well telescopes please sketch and show depths.

GROUND LEVEL

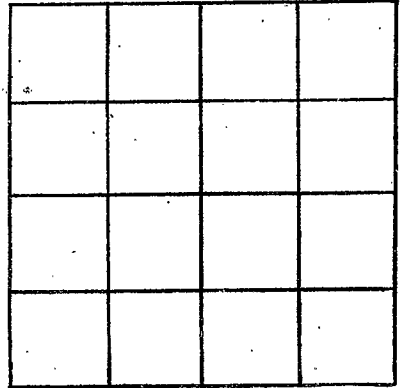

SECTION _____

Please indicate well location X.

ADDITIONAL INFORMATION

If more than one screen,
show locations of each on sketch.