

Pearl River
U56
9-3-71

MISSISSIPPI
 BOARD OF WATER COMMISSIONERS
 416 North State Street
 Jackson, Mississippi 39201

WATER WELL DRILLERS LOG

9-3- 19 71
 date well completed

NEIL LUMPKIN WELL DRILLING
 P. O. BOX 117
 CARRIERE, MISS.

CODED Lever
 county well located

LANDOWNER: J.F. Melancon
CARRIERE, Miss.
Rock Ranch Rd.
 (mailing address)

description of formations
 encountered

from to

Surface Clay 0 40
Good Sand 40 85

WELL LOCATION:

sec. 18 T. 5 S. R. 17 E.
7 miles W. of CARRIERE
 (distance) (direction) (nearest town)

WELL PURPOSE: home
 (home, irrigation, municipal, industrial)

WELL COMPLETION DATA:

- (1) diameter (inches) 2"
- (2) total depth (feet) 85
- (3) static water level (feet) 20 below ~~above~~ top of ground.
- (4) casing plastic (material), (depth)
2" (size) If telescope see back.
- (5) screen 5' (length), (depth to top)
2" (size), plastic (material)
- (6) pump 1/2 (HP), 450 gpm (yield gpm)
electric (type power)
- (7) electric log No. (yes or no)

CODED

(organization running log)

(8) how well bottom plugged Johnson
back pressure valve


OCT 11 1971

DRILLERS REMARKS:

MISSISSIPPI
 BOARD OF WATER COMMISSIONERS
 JACKSON, MISSISSIPPI

If well telescopes please sketch and show depths.

GROUND LEVEL

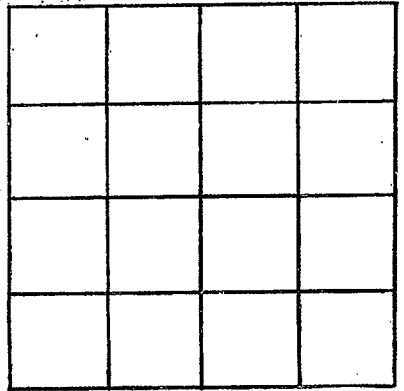

SECTION _____

Please indicate well location X.

ADDITIONAL INFORMATION

If more than one screen,
show locations of each on sketch.