

PEARL RIVER  
U 57  
9-17-71

MISSISSIPPI  
BOARD OF WATER COMMISSIONERS  
416 North State Street  
Jackson, Mississippi 39201

WATER WELL DRILLERS LOG

9-17-1971 NEIL LUMPKIN WELL DRILLING SERVICE Pearl River  
date well completed 2971 P.O. BOX 117 county well located  
CARRIERE, MISS.

LANDOWNER: Paul Erickson

description of formations encountered from to

Picayune, Miss.  
Route 2, Box 204  
(mailing address)

surface clay 0 20  
sand + gravel 20 120

WELL LOCATION:  
sec. 32 T. 5 S. R. 17 E.  
5 miles W of Picayune  
(distance) (direction) (nearest town)

blue clay 120 200  
sand 200 300

WELL PURPOSE: home  
(home, irrigation, municipal, industrial)

blue clay 300 450  
good sand 450 560

WELL COMPLETION DATA:

- (1) diameter (inches) 2" 1050'
- (2) total depth (feet) \_\_\_\_\_
- (3) static water level (feet) 40 below above top of ground.
- (4) casing black (material) \_\_\_\_\_ (depth)
- 2" (size) if telescope see back.
- (5) screen 20' (length) \_\_\_\_\_ (depth to top)
- 2" (size) \_\_\_\_\_ (material)
- (6) pump \_\_\_\_\_ (HP) \_\_\_\_\_ (yield gpm)
- \_\_\_\_\_ (type power)
- (7) electric log no. (yes or no)
- \_\_\_\_\_ (organization running log)

blue clay 560 720  
good sand 720 790  
blue clay 790 940  
good sand 940 1050

(8) how well bottom plugged Johnson back pressure valve

DRILLERS REMARKS: \_\_\_\_\_

**CODED**


**CODED**

OCT 11 1971

MISS. Bd. OF WATER COMMISSIONERS

If well telescopes please sketch and show depths.

GROUND LEVEL

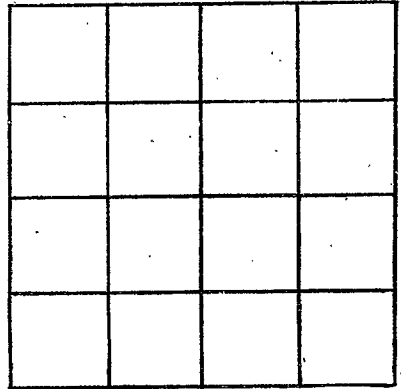

SECTION \_\_\_\_\_

Please indicate well location X.

ADDITIONAL INFORMATION

If more than one screen,  
show locations of each on sketch.