

PEARL RIVER
U 58
9-24-71

MISSISSIPPI
 BOARD OF WATER COMMISSIONERS
 416 North State Street
 Jackson, Mississippi 39201

WATER WELL DRILLERS LOG

CODED
 Pearl River

9-24 1971 WELL LUMPKIN WELL DRILLING P. O. BOX 117
 date well completed firm name county well located

LANDOWNER: Michael Smith
Carriere, Ms. R.H.

description of formations encountered	from	to
<u>Surface clay</u>	<u>0</u>	<u>10</u>
<u>Sand & gravel</u>	<u>10</u>	<u>38</u>
<u>white clay</u>	<u>38</u>	<u>70</u>
<u>Blue clay</u>	<u>70</u>	<u>150</u>
<u>Good sand</u>	<u>150</u>	<u>195</u>

(mailing address)

WELL LOCATION:
 sec. 8 T. 5 S. R. 17
7 miles W of Carriere
 (distance) (direction) (nearest town)

WELL PURPOSE: home
 (home, irrigation, municipal, industrial)

- WELL COMPLETION DATA:
- (1) diameter (inches) 2"
 - (2) total depth (feet) 195
 - (3) static water level (feet) 60 below above top of ground.
 - (4) casing galv. (material) (depth) 2" (size) If telescope see back.
 - (5) screen 5' (length) (depth to top) 2" (size) St. Steel (material)
 - (6) pump 1 (HP) 550 gpm. (yield gpm)
electric (type power)
 - (7) electric log No. (yes or no)

CODED

(organization running log)

(8) how well bottom plugged Johnson
B.P. Valve


OCT 11 1971

DRILLERS REMARKS:

MISS. BD. OF
 WATER COM.

If well telescopes please sketch and show depths.

GROUND LEVEL

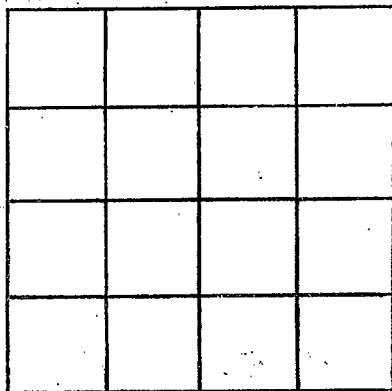

SECTION _____

Please indicate well location X.

ADDITIONAL INFORMATION

If more than one screen, show locations of each on sketch.