

PEARL River
U 62
12-27-71

MISSISSIPPI
 BOARD OF WATER COMMISSIONERS
 416 North State Street
 Jackson, Mississippi 39201

CODED

WATER WELL DRILLERS LOG

12-27 1971
 date well completed

Bud Lentonsen Pearl River
 firm name

county well located

LANDOWNER:

Jimmy Kennedy
Route 1
Carrine, Miss
 (mailing address)

description of formations encountered

from

to

<u>Red Shale</u>	<u>0</u>	<u>8</u>
<u>White Sand</u>	<u>8</u>	<u>32</u>
<u>Blue Shale</u>	<u>32</u>	<u>96</u>
<u>Blue Sand & Gravel</u>	<u>96</u>	<u>186</u>
<u>Gravel</u>	<u>186</u>	<u>264</u>
<u>Blue Shale</u>	<u>264</u>	<u>416</u>
<u>Blue Sand</u>	<u>416</u>	<u>441</u>

WELL LOCATION:

sec. 10 T S N R 17 E
2 miles W of Carrine
 (distance) (direction) (nearest town)

WELL PURPOSE:

Home
 (home, irrigation, municipal, industrial)

WELL COMPLETION DATA:

- (1) diameter (inches) 2 in
- (2) total depth (feet) 441
- (3) static water level (feet) 16 1/2 ^{feet} below top of ground.
- (4) casing Galv. 4 1/2" x 38'
 (material) (depth)
- (size) if telescope see back.
- (5) screen 20ft. 4 1/2"
 (length) (depth to top)
- 2x20 S. Steel No 15
 (size) (material)
- (6) pump _____ (HP) _____ (yield gpm)
- fls.
 (type power)
- (7) electric log no
 (yes or no)

(organization running log)

(8) how well bottom plugged Sand Shale

DRILLERS REMARKS:


CODED

JAN 31 1972

MISS. BD. OF WATER COMMISSIONERS

If well telescopes please sketch and show depths.

GROUND LEVEL

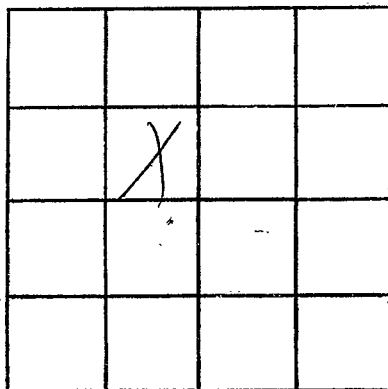

SECTION _____

Please indicate well location X.

ADDITIONAL INFORMATION

If more than one screen,
show locations of each on sketch.