

PEARL RIVER  
U 63  
1-22-72

MISSISSIPPI  
 BOARD OF WATER COMMISSIONERS  
 416 North State Street  
 Jackson, Mississippi 39201

**CODED**

WATER WELL DRILLERS LOG

1-22 1972 Bad Renton's Son Pearl River  
 date well completed firm name county well located

LANDOWNER: Wayne Hall  
Rt. 1  
Carnie Miss  
 (mailing address)

description of formations encountered	from	to
	<u>Red Shale</u>	<u>0</u>
<u>Blue Shale</u>	<u>14</u>	<u>204</u>
<u>Blue Sand</u>	<u>204</u>	<u>204</u>

WELL LOCATION:  
 sec. 10 T. 5 N R. 17 E  
4 miles W of Carnie  
 (distance) (direction) (nearest town)

WELL PURPOSE: Home  
 (home, irrigation, municipal, industrial)

- WELL COMPLETION DATA:
- (1) diameter (inches) 2 in
  - (2) total depth (feet) 204
  - (3) static water level (feet) 55.1 <sup>ft</sup> below top of ground.
  - (4) casing Galv. 259  
 (material) (depth)  
 (size) if telescope see back.
  - (5) screen 5' 259  
 (length) (depth to top)  
2x5 S. Steel  
 (size) (material)
  - (6) pump 1 410  
 (HP) (yield gpm)  
electric  
 (type power)
  - (7) electric log NO  
 (yes or no)

**CODED**

(organization running log)

(8) how well bottom plugged:  
Sand Shale


DRILLERS REMARKS:

JAN 31 1972

MISSISSIPPI  
 BOARD OF WATER COMMISSIONERS

If well telescopes please sketch and show depths.

GROUND LEVEL

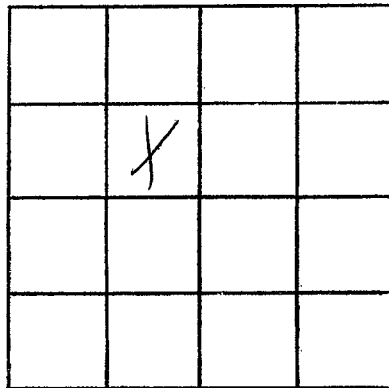

SECTION \_\_\_\_\_

Please indicate well location X.

ADDITIONAL INFORMATION

If more than one screen, show locations of each on sketch.