

PEARL RIVER
U 65
11-16-71

MISSISSIPPI
 BOARD OF WATER COMMISSIONERS
 416 North State Street
 Jackson, Mississippi 39201

WATER WELL DRILLERS LOG

11-16 date well completed 71 East Patted water well serv Pearl River firm name county well located

LANDOWNER: A. L. Warriner
Rt. 1 Cordere Miss.
 (mailing address)

WELL LOCATION:
 sec. 11 T 5 N R 17 E
4 miles west of Mossil
 (distance) (direction) (nearest town)

WELL PURPOSE: Home
 (home, irrigation, municipal, industrial)

WELL COMPLETION DATA:
 (1) diameter (inches) 4 1/2
 (2) total depth (feet) 215
 (3) static water level (feet) 75 below top of ground.
 (4) casing Galv. (material), 210 (depth)
 (size) if telescope see back.
 (5) screen 5' (length), 210- (depth to top)
2" (size), 5.5 (material)
 (6) pump 1 (HP), 350 Gp. (yield gpm)
Elect. (type power)
 (7) electric log NO (yes or no)
 (organization running log)
 (8) how well bottom plugged Shoe


description of formations encountered	from	to
<u>Red clay</u>	<u>0.</u>	<u>16</u>
<u>white sd. & gravel</u>	<u>No.</u>	<u>70</u>
<u>white clay</u>	<u>70</u>	<u>115</u>
<u>Blue Clay</u>	<u>115</u>	<u>174</u>
<u>Fine Blue sd.</u>	<u>174</u>	<u>205</u>
<u>coarse Blue sd.</u>		
<u>2 Gravel</u>	<u>205</u>	<u>215</u>

MAR 20 1972

DRILLERS REMARKS:

If well telescopes please sketch and show depths.

GROUND LEVEL

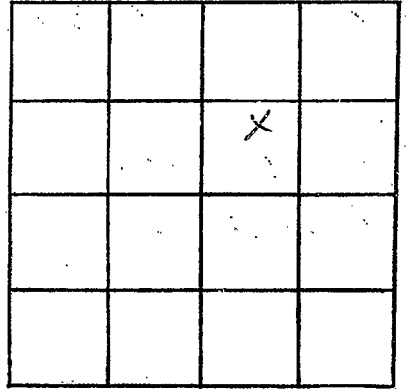

SECTION 11

Please indicate well location X.

ADDITIONAL INFORMATION

If more than one screen,
show locations of each on sketch.