

PEARL RIVER
 U 66
 2-25-72

MISSISSIPPI
 BOARD OF WATER COMMISSIONERS
 416 North State Street
 Jackson, Mississippi 39201

MAR 8 1972

WATER WELL DRILLERS LOG

2-25 date well completed 1972 Bud Penton's son firm name Pearl River county well located

LANDOWNER: Grady Landry
Route 1
Carriere, Miss.
 (mailing address)

description of formations encountered	from	to
Red shale	0	8
Red sand	8	20
Red shale	20	32
Blue shale	32	180
White sand	180	244

WELL LOCATION:
 sec. 5 T. 17 N. R. 17 E.
 4 miles W of Carriere
 (distance) (direction) (nearest town)

WELL PURPOSE: Home
 (home, irrigation, municipal, industrial)

WELL COMPLETION DATA:

(1) diameter (inches) 2 in

(2) total depth (feet) 244

(3) static water level (feet) 231 below top of ground.

(4) casing Galv. 239
 (material) (depth)

(size) if telescope see back.

(5) screen 5 ft. 239
 (length) (depth to top)

2x5 Stainless S. wire
 (size) (material)

(6) pump 1 450
 (HP) (yield gpm)


electric
 (type power)

(7) electric log no
 (yes or no)

(organization running log)


(8) how well bottom plugged
and shank

DRILLERS REMARKS:

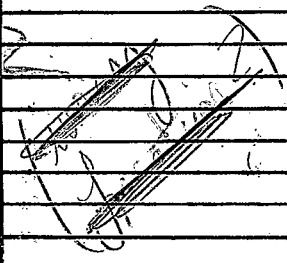

If well telescopes please sketch and show depths.

GROUND LEVEL

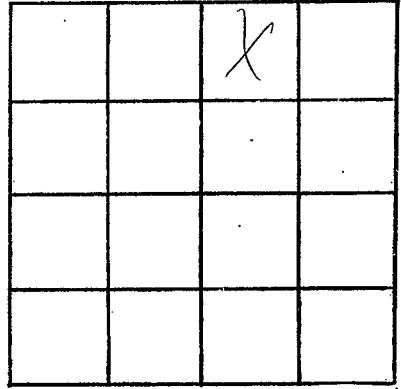

SECTION _____

Please indicate well location X.

ADDITIONAL INFORMATION

If more than one screen, show locations of each on sketch.