

PEARL RIVER
U67
4-3-72

MISSISSIPPI
 BOARD OF WATER COMMISSIONERS
 416 North State Street
 Jackson, Mississippi 39201

WATER WELL DRILLERS LOG

CODED

4-3 1972 Bud Patten's Son Pearl River
 date well completed firm name county well located

LANDOWNER:
William Garland Harris
Carmie, Miss.
 (mailing address)

WELL LOCATION:
 sec. 2 T 5 N R 17 E
2 miles N.W. of Carmie
 (distance) (direction) (nearest town)

WELL PURPOSE: Home
 (home, irrigation, municipal, industrial)

WELL COMPLETION DATA:
 (1) diameter (inches) 2 1/2
 (2) total depth (feet) 309
 (3) static water level (feet) 16 below top of ground.
 (4) casing Galv. 484
 (material) (depth)
 (size) if telescope see back.
 (5) screen 2x20, 484
 (length) (depth to top)
2x20, S. Steel no. 12
 (size) (material)
 (6) pump _____ (HP) _____ (yield gpm)
 (type power)
 (7) electric log No
 (yes or no)
 (organization running log)
 (8) how well bottom plugged Sand Shale

description of formations encountered	from	to
<u>White Shale</u>	<u>0</u>	<u>8</u>
<u>White Sand</u>	<u>8</u>	<u>38</u>
<u>Blue Shale</u>	<u>38</u>	<u>96</u>
<u>Blue Sand</u>	<u>96</u>	<u>300</u>
<u>Blue Clay</u>	<u>300</u>	<u>324</u>
<u>Blue Sand</u>	<u>324</u>	<u>458</u>
<u>Blue Shale</u>	<u>458</u>	<u>475</u>
<u>Sand & Rock</u>	<u>475</u>	<u>530</u>

CODED


NOV 3 - 1972

DRILLERS REMARKS:

MISS. Bd. of
 WATER COMMISSIONERS

If well telescopes please sketch and show depths.

GROUND LEVEL

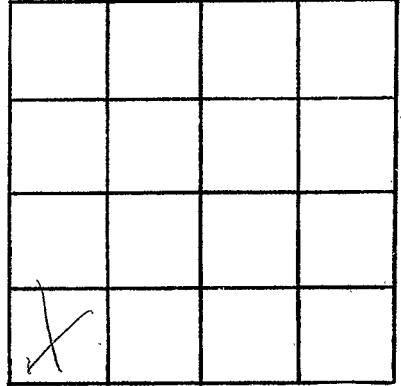

SECTION _____

Please indicate well location X.

ADDITIONAL INFORMATION

If more than one screen, show locations of each on sketch.