

**PEARL RIVER**  
 U 68  
 5-11-72

MISSISSIPPI  
 BOARD OF WATER COMMISSIONERS  
 416 North State Street  
 Jackson, Mississippi 39201

**CODED**

**WATER WELL DRILLERS LOG**

5-11-1972 **NEIL LUMPKIN WELL DRILLING SERVICE** Pearl River  
 P. O. BOX 117  
 Pearl River, MISS. county well located

LANDOWNER	description of formations encountered	from	to
<b>Paul Brock</b> <b>Picayune, Ms.</b> <b>Highway 43 N</b> (mailing address)	Surface clay	0	20
<b>WELL LOCATION:</b> sec. <u>33</u> T. <u>5</u> S. R. <u>17</u> E. <u>2</u> miles <u>W</u> of <u>Picayune</u> (distance) (direction) (nearest town)	Sand & gravel	20	120
<b>WELL PURPOSE:</b> <u>home</u> (home, irrigation, municipal, industrial)	Blue clay	120	200
<b>WELL COMPLETION DATA:</b> (1) diameter (inches) <u>2"</u> (2) total depth (feet) <u>10.50'</u> (3) static water level (feet) <u>34</u> <del>below</del> above top of ground. (4) casing <u>galv.</u> (material), (depth) _____ <u>2"</u> (size) if telescope see back. (5) screen <u>20'</u> (length), (depth to top) _____ <u>2"</u> (size), <u>St. Steel</u> (material) (6) pump _____ (HP) _____ (yield gpm) _____ (type power)	Sand	200	300
(7) electric log <u>No</u> (yes or no) _____ (organization running log) (8) how well bottom plugged <u>Sand shock</u> <u>A.P. Valve</u>	Blue clay	300	450
<b>DRILLERS REMARKS:</b> <u>17 lbs. pressure</u>	Good sand	450	560
	Blue clay	560	720
	Good sand	720	790
	Blue clay	790	940
	Good sand	940	1050


**CODED**

MAY 24 1972

MISS. BI  
 WASH. CONTS

If well telescopes please sketch and show depths.

GROUND LEVEL

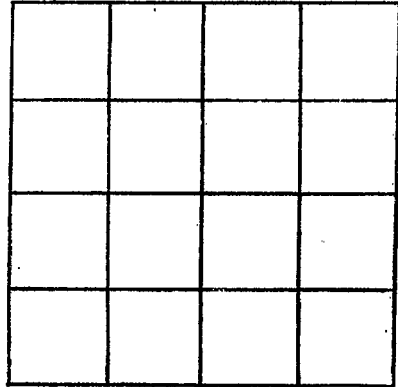

SECTION \_\_\_\_\_

Please indicate well location X.

ADDITIONAL INFORMATION

Lined area for additional information, consisting of 20 horizontal lines.

If more than one screen, show locations of each on sketch.