

PEARL RIVER
U 69
5-22-72

MISSISSIPPI
 BOARD OF WATER COMMISSIONERS
 416 North State Street
 Jackson, Mississippi 39201

CODED

WATER WELL DRILLERS LOG

NEIL LUMPKIN WELL DRILLING SERVICE
 P. O. BOX 117

Pearl River

5-22- 1972
 date well completed

BARBOUR, MISS.

county well located

| LANDOWNER: <u>Steve Fleming</u> <u>Picayune, Miss.</u> | description of formations encountered | from | to |
|--|---------------------------------------|------------|------------|
| (mailing address) | | | |
| WELL LOCATION: sec. 7 <u>33</u> T. 3 <u>5</u> S. R. 13 <u>17</u> W. (distance) miles (direction) of (nearest town) <u>1</u> miles <u>N.</u> of <u>Picayune</u> | <u>Surface clay</u> | <u>0</u> | <u>10</u> |
| | <u>Sand & gravel</u> | <u>10</u> | <u>65</u> |
| | <u>Blue clay</u> | <u>65</u> | <u>180</u> |
| | <u>Good sand</u> | <u>180</u> | <u>207</u> |
| WELL PURPOSE: <u>Home</u> (home, irrigation, municipal, industrial) | | | |
| WELL COMPLETION DATA: | | | |
| (1) diameter (inches) <u>2"</u> | | | |
| (2) total depth (feet) <u>207</u> | | | |
| (3) static water level (feet) <u>20</u> below above top of ground. | | | |
| (4) casing <u>galv.</u> (material), (depth) _____ <u>24</u> (size) if telescope see back. | | | |
| (5) screen <u>5'</u> (length), <u>207</u> (depth to top) <u>2"</u> (size), <u>Steel</u> (material) | | | |
| (6) pump <u>1/2</u> (HP), <u>550</u> per hr. (yield gpm) <u>electric</u> (type power) | | | |
| (7) electric log <u>no</u> (yes or no) | | | |
| (organization running log) | | | |
| (8) how well bottom plugged <u>Gaboon</u> <u>back-pressure valve</u> | | | |
| DRILLERS REMARKS: | | | |


CODED

JUN 20 1972

MISS. BD. OF
 WATER COMMISSIONERS

If well telescopes please
sketch and show depths.

GROUND LEVEL

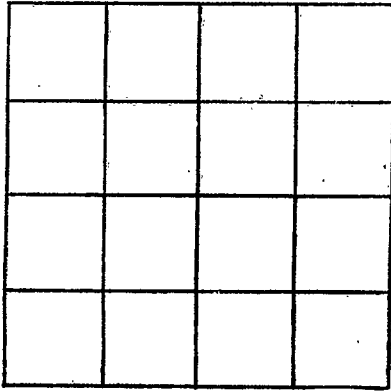

SECTION _____

Please indicate well location X.

ADDITIONAL INFORMATION

If more than one screen,
show locations of each on sketch.