

**PEARL RIVER**  
**U 72**  
**7-3-72**

MISSISSIPPI  
 BOARD OF WATER COMMISSIONERS  
 416 North State Street  
 Jackson, Mississippi 39201

**CODED**

**WATER WELL DRILLERS LOG**

date well completed

firm name

county well located

7-3 1972 Bud Kuster & Son Pearl River

LANDOWNER:  
 Carlos Creel  
 Carver, Miss.  
 (mailing address)

description of formations encountered from to

WELL LOCATION:  
 sec 26 T 5 N R 17 E  
 3 miles S of Carver  
 (distance) (direction) (nearest town)

WELL PURPOSE: Home  
 (home, irrigation, municipal, industrial)

- WELL COMPLETION DATA:
- (1) diameter (inches) 2 1/2
  - (2) total depth (feet) 324
  - (3) static water level (feet) 168 below top of ground
  - (4) casing Galv. 3 1/2 (material) (depth)
  - (size) if telescope see back.
  - (5) screen 2 1/2 x 5 3 1/2 (length) (depth to top)
  - 2 1/2 x 5 (size) S. Steel (material)
  - (6) pump 1 450 (HP) (yield gpm)
  - electric (type power)
  - (7) electric log NO (yes or no)

**CODED**

(organization running log)


how well bottom plugged  
 mud shale

DATE 7 0 1972

WELLER'S SIGNATURE

If well telescopes please sketch and show depths.

GROUND LEVEL

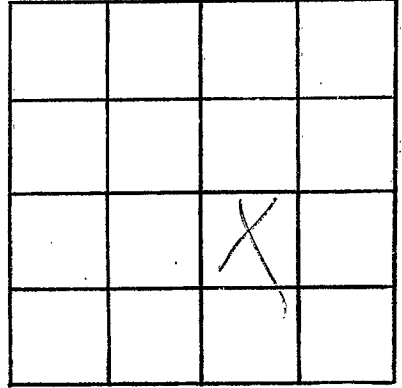

SECTION \_\_\_\_\_

Please indicate well location X.

ADDITIONAL INFORMATION

If more than one screen, show locations of each on sketch.