

PEARL RIVER
U 74
4-14-72

MISSISSIPPI
 BOARD OF WATER COMMISSIONERS
 416 North State Street
 Jackson, Mississippi 39201

CODED

WATER WELL DRILLERS LOG

4-14 72 Pearl Redford water well serv. Pearl River
 date well completed firm name county well located

LANDOWNER:
Lastré Mc Taylor
Carriere, Miss.
 (mailing address)

WELL LOCATION:
 sec 10 T 5 N R 17 E
2 miles West of Carriere
 (distance) (direction) (nearest town)

WELL PURPOSE: Home
 (home, irrigation, municipal, industrial)

- WELL COMPLETION DATA:**
- (1) diameter (inches) 4 3/4
 - (2) total depth (feet) 100
 - (3) static water level (feet) 30 below/above top of ground.
 - (4) casing Pvc 95'
 (material) (depth)
2" if telescope see back.
 (size)
 - (5) screen 5 95
 (length) (depth to top)
2" P.V.C.
 (size) (material)
 - (6) pump 1 500
 (HP) (yield gpm)
Electric
 (type power)
 - (7) electric log NO
 (yes or no)
 (organization running log)
 - (8) how well bottom plugged Shoe

description of formations encountered	from	to
Red clay	0	7
white clay	7	14
white coarse sd	14	24
White clay	24	40
Blue clay	40	70
fine grey sd.	70	85
Coarse br. sd. & Gr.	85	100


CODED

APR 21 1972

DRILLERS REMARKS:

If well telescopes please sketch and show depths.

GROUND LEVEL

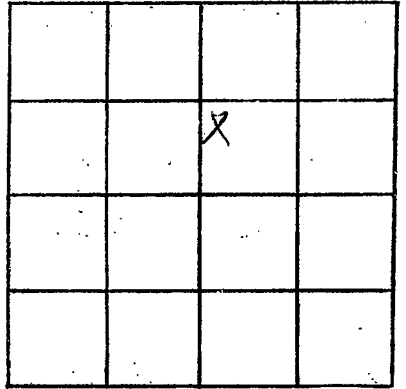

SECTION 10

Please indicate well location X.

ADDITIONAL INFORMATION

If more than one screen, show locations of each on sketch.