

PEARL RIVER  
U 76  
10-13-72

MISSISSIPPI  
 BOARD OF WATER COMMISSIONERS  
 416 North State Street  
 Jackson, Mississippi 39201

WATER WELL DRILLERS LOG

10-13 1972 PEARL RIVER LUMPKIN WELL DRILLING SERVICE  
 date well completed P. O. BOX 117  
 CANTON, MISS. county well located


LANDOWNER: <u>Freeman Davis</u>	description of formations encountered	from	to
<u>Picayune Route</u> <u>(Virginia Manser)</u> (mailing address)			
<b>WELL LOCATION:</b>			
sec. <u>34</u> T. <u>5</u> NE R. <u>17</u> E	<u>Surface clay</u>	<u>0</u>	<u>18</u>
<u>2</u> miles <u>NW</u> of <u>Picayune</u>	<u>Sand &amp; gravel</u>	<u>18</u>	<u>110</u>
(distance) (direction) (nearest town)	<u>Blue clay</u>	<u>110</u>	<u>250</u>
<b>WELL PURPOSE:</b> <u>home</u> (home, irrigation, municipal, industrial)			
<b>WELL COMPLETION DATA:</b>			
(1) diameter (inches) <u>2" galv.</u>	<u>Good sand</u>	<u>250</u>	<u>340</u>
(2) total depth (feet) <u>1008</u>	<u>Blue clay</u>	<u>340</u>	<u>460</u>
(3) static water level (feet) <u>40</u> <sup>below</sup> top of ground.	<u>Good sand</u>	<u>460</u>	<u>590</u>
(4) casing <u>galv.</u> (material), (depth)	<u>Blue clay</u>	<u>590</u>	<u>695</u>
<u>2"</u> (size) if telescope see back.	<u>Good sand</u>	<u>695</u>	<u>750</u>
(5) screen <u>20</u> (length), (depth to top)	<u>Blue clay</u>	<u>750</u>	<u>920</u>
<u>2"</u> (size), <u>S. Steel</u> (material)	<u>Good sand</u>	<u>920</u>	<u>1008</u>
(6) pump (HP) (yield gpm)			
(type power)			
(7) electric log <u>No</u> (yes or no)			
(organization running log)			
(8) how well bottom plugged <u>Sand</u> <u>Sharks</u>			
<b>DRILLERS REMARKS:</b> <u>18 lbs. pressure</u>			

NOV 15 1972

Miss. Bd. of  
 WATER

If well telescopes please sketch and show depths.

GROUND LEVEL

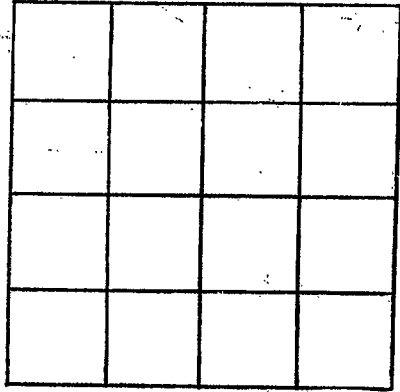

SECTION \_\_\_\_\_

Please indicate well location X.

ADDITIONAL INFORMATION

A series of 20 horizontal lines provided for entering additional information.

If more than one screen, show locations of each on sketch.