

PEARL RIVER
U 77
8-16-72

MISSISSIPPI
 BOARD OF WATER COMMISSIONERS
 416 North State Street
 Jackson, Mississippi 39201

WATER WELL DRILLERS LOG

8-16-1972
 date well completed

NEIL LUMPKIN W. ENGINEERING SERVICE
 P. O. BOX 117
 GARRLEE, MISS.

county well located
Pearl River


LANDOWNER	description of formations encountered	from	to
<u>Chas. Knapp</u> <u>Picayune, Miss.</u>	<u>Surface clay</u>	<u>0</u>	<u>20</u>
<u>Rt. 2 Box 196 AA</u> (mailing address)	<u>Sand & gravel</u>	<u>20</u>	<u>120</u>
WELL LOCATION: sec. <u>30</u> T <u>5</u> S R. <u>17</u> E	<u>Blue Clay</u>	<u>120</u>	<u>200</u>
<u>7</u> miles <u>W</u> of <u>Picayune</u> (distance) (direction) (nearest town)	<u>Good sand</u>	<u>200</u>	<u>350</u>
WELL PURPOSE: <u>Home</u> (home, irrigation, municipal, industrial)	<u>Blue Clay</u>	<u>350</u>	<u>500</u>
WELL COMPLETION DATA:	<u>Good sand</u>	<u>500</u>	<u>600</u>
(1) diameter (inches) <u>2"</u>	<u>Blue clay</u>	<u>600</u>	<u>670</u>
(2) total depth (feet) <u>756'</u>	<u>Good sand</u>	<u>670</u>	<u>756</u>
(3) static water level (feet) <u>23</u> above top of ground.			
(4) casing <u>galv.</u> (material), <u>30'</u> (depth)			
<u>2"</u> (size) If telescope see back.			
(5) screen <u>20'</u> (length), (depth to top)			
<u>2"</u> (size), <u>St. Steel</u> (material)			
(6) pump (HP) (yield gpm)			
(type power)			
(7) electric log <u>No</u> (yes or no)			
(organization running log)			
(8) how well bottom plugged			
DRILLERS REMARKS: <u>Johnson BP Valve</u> <u>10 lbs. pressure</u>			

NOV 15 1972

MISS. BD. OF WATER COMMISSIONERS

If well telescopes please sketch and show depths.

GROUND LEVEL

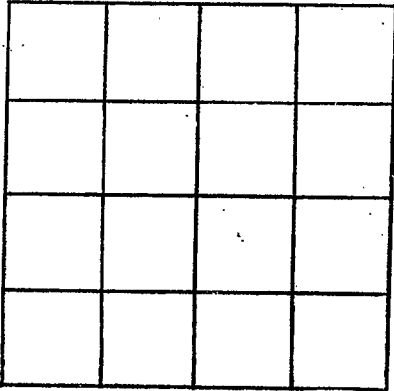

SECTION _____

Please indicate well location X.

ADDITIONAL INFORMATION

A series of horizontal lines for entering additional information.

If more than one screen, show locations of each on sketch.