

PEARL RIVER
U 79
11-7-72

MISSISSIPPI
 BOARD OF WATER COMMISSIONERS
 416 North State Street
 Jackson, Mississippi 39201

WATER WELL DRILLERS LOG

NEIL LUMPKIN WELL DRILLING SERVICE
 P. O. BOX 117
 CARRIER, MISS.

Pearl River
 county well located

11-9 1972
 date well completed


LANDOWNER:	description of formations encountered	from	to
<u>O. W. Entekin</u> <u>Picayune, Miss. Rt.</u> (mailing address)			
	<u>Sand + gravel.</u>	<u>15</u>	<u>110</u>
WELL LOCATION: sec. <u>29</u> T <u>5</u> S R <u>17</u> E W	<u>Blue Clay</u>	<u>110</u>	<u>230</u>
<u>5</u> miles <u>W</u> of <u>Carrier</u> (distance) (direction) (nearest town)	<u>Good sand</u>	<u>230</u>	<u>320</u>
WELL PURPOSE: <u>home</u> (home, irrigation, municipal, industrial)	<u>Blue clay</u>	<u>320</u>	<u>450</u>
WELL COMPLETION DATA:	<u>Sand + clay mixed</u>	<u>450</u>	<u>535</u>
(1) diameter (inches) <u>2"</u>	<u>Blue clay</u>	<u>535</u>	<u>620</u>
(2) total depth (feet) <u>714'</u>	<u>Fine to better sand</u>	<u>620</u>	<u>714</u>
(3) static water level (feet) <u>16</u> ^{below} top of ground			
(4) casing <u>483' black 210 galv.</u> (material) (depth)			
<u>2"</u> (size) if telescope see back.			
(5) screen <u>20'</u> (length) (depth to top)			
<u>2" St. Steel</u> (size) (material)			
(6) pump _____ (HP) _____ (yield gpm)			
(type power) _____			
(7) electric log <u>No.</u> (yes or no)			
(organization running log) _____			
(8) how well bottom plugged <u>Sand</u> <u>Shank B P V</u>			
DRILLERS REMARKS: <u>10 lbs or less.</u>			

NOV 15 1972

DRILLERS STAMP

If well telescopes please sketch and show depths.

GROUND LEVEL

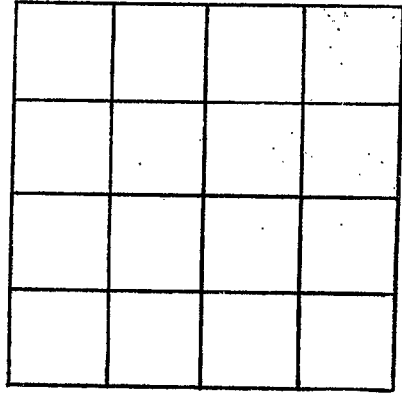

SECTION _____

Please indicate well location X.

ADDITIONAL INFORMATION

If more than one screen,
show locations of each on sketch.