

PEARL RIVER
 U 80
 9-8-72

MISSISSIPPI
 BOARD OF WATER COMMISSIONERS
 416 North State Street
 Jackson, Mississippi 39201

CLIMED

WATER WELL DRILLERS LOG


9-8-72 date well completed 1972 Earl Penford water well serv. Pearl River firm name county well located

LANDOWNER:	description of formations encountered	from	to
Mrs. Ethel Wedgast	Red clay	0	3
Carriere, Miss. (mailing address)	white sd. & gravel	3	32
WELL LOCATION: sec. 21 T. 2 S. R. 17 E. 2 miles west of Ozona (distance) (direction) (nearest town)	white clay	32	58
	Blue clay	58	164
WELL PURPOSE: Home (home, irrigation, municipal, industrial)	Fine Blue sd.	164	174
WELL COMPLETION DATA:	Blue clay	174	270
(1) diameter (inches) 4 5/8	Fine Blue sd.	270	300
(2) total depth (feet) 308	med Blue sd.	300	308
(3) static water level (feet) 40 below top of ground.			
(4) casing Galv. 303 (material) (depth) 2" if telescope see back. (size)			
(5) screen 5' 303 (length) (depth to top) 2" S. Steel (size) (material)			
(6) pump 1 4.30 (HP) (yield gpm) Elect (type power)			
(7) electric log NO (yes or no)			
(8) how well bottom plugged Shoe			
DRILLERS REMARKS:			

NOV 27 1972

If well telescopes please sketch and show depths.

GROUND LEVEL

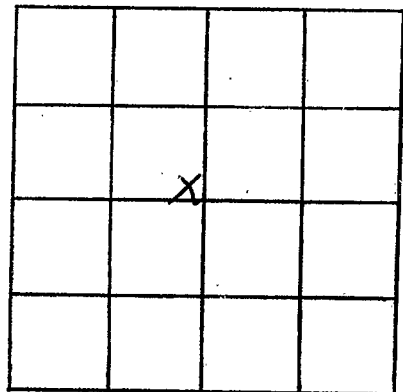

SECTION 21

Please indicate well location X.

ADDITIONAL INFORMATION

Lined area for additional information.

If more than one screen, show locations of each on sketch.