

PEARL RIVER
 U 81
 11-16-72

MISSISSIPPI
 BOARD OF WATER COMMISSIONERS
 416 North State Street
 Jackson, Mississippi 39201

CODED

WATER WELL DRILLERS LOG

NEIL LUMPKIN WELL DRILLING SERVICE Pearl River
 P. O. BOX 117
 CLARKSTON, MISS. county well located

11-16-1972
 date well completed

LANDOWNER: Mrs. Viola
 Armstrong
 Carrriere
 Route 1
 (mailing address)

description of formations encountered	from	to
Surface Clay	0	20
sand	20	40
Blue Clay	40	60
Good sand	60	90

WELL LOCATION:
 sec. ~~5~~ T. 5 N. R. 17 E.
 6 miles W of Carrriere
 (distance) (direction) (nearest town)

WELL PURPOSE: home
 (home, irrigation, municipal, industrial)

- WELL COMPLETION DATA:
- (1) diameter (inches) 4"
 - (2) total depth (feet) 90
 - (3) static water level (feet) 24 below top of ground.
 - (4) casing plastic (material), 4" (size) (depth) If telescope see back.
 - (5) screen 10' (length), 4" (size), plastic (material) (depth to top)
 - (6) pump 3/4 (HP), 3000 gpm (yield gpm), electric (type power)
 - (7) electric log no (yes or no)

(organization running log)


(8) how well bottom plugged Sand sharp (B)

DRILLERS REMARKS:

JAN 17 1973

If well telescopes please sketch and show depths.

GROUND LEVEL

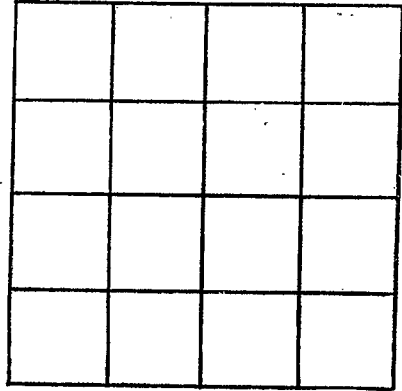

SECTION _____

Please indicate well location X.

ADDITIONAL INFORMATION

A series of horizontal lines for recording additional information, starting below the 'ADDITIONAL INFORMATION' header and extending to the bottom of the page.

If more than one screen, show locations of each on sketch.