

PEARL RIVER
U 82
11-22-72

MISSISSIPPI
 BOARD OF WATER COMMISSIONERS
 416 North State Street
 Jackson, Mississippi 39201

CODED

WATER WELL DRILLERS LOG
 NEIL LUMPKIN WELL DRILLING SERVICE

P. O. BOX 117
 CARRIERE, MISS.

Pearl River
 county well located

11-22-72 1972
 date well completed

LANDOWNER: Sidney
MacRae Seal
Picayune Route
 (mailing address)

description of formations encountered	from	to
<u>Surface clay</u>	<u>0</u>	<u>20</u>
<u>Sand</u>	<u>20</u>	<u>35</u>
<u>Clay</u>	<u>35</u>	<u>250</u>
<u>Good sand</u>	<u>250</u>	<u>375</u>
<u>Clay</u>	<u>375</u>	<u>445</u>
<u>Sand</u>	<u>445</u>	<u>470</u>
<u>Clay</u>	<u>470</u>	<u>625</u>
<u>Sand</u>	<u>625</u>	<u>740</u>
<u>Clay</u>	<u>740</u>	<u>940</u>
<u>Good Sand</u>	<u>940</u>	<u>1008</u>

WELL LOCATION:
 sec. 30 T. 5 N. R. 17 E.
 S W
7 miles (distance) SW (direction) of Carrierre (nearest town)


WELL PURPOSE: home
 (home, irrigation, municipal, industrial)

WELL COMPLETION DATA:
 (1) diameter (inches) 2
 (2) total depth (feet) 1008
 (3) static water level (feet) 40 below top of ground.
 (4) casing black (material), 4 1/2 gal (depth) on top
2" if telescope see back. (size)
 (5) screen 20' (length), (depth to top)
2" (size), S. Steel (material)
 (6) pump 70 gpm. (HP) (y/feld gpm)
 (type power)
 (7) electric log no (yes or no)
 (organization running log)
 (8) how well bottom plugged: Sand
shark BPV

DRILLERS REMARKS:
18 lbs pressure
Good volume

If well telescopes please sketch and show depths.

GROUND LEVEL

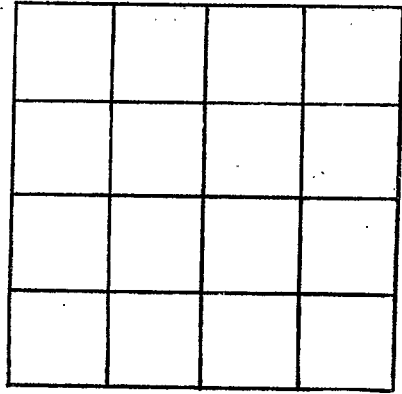

SECTION _____

Please indicate well location X.

ADDITIONAL INFORMATION

A series of horizontal lines providing space for additional information.

If more than one screen, show locations of each on sketch.