

Pearl River
U84
3-5-73

MISSISSIPPI
 BOARD OF WATER COMMISSIONERS
 416 North State Street
 Jackson, Mississippi 39201

CODED

WATER WELL DRILLERS LOG

NEIL LUMPKIN WELL DRILLING SERVICE
 P. O. BOX 117
 CARROLLTON, MISS.

Pearl River
 county well located

3-5-
 date well completed

73
 19

firm name


LANDOWNER	description of formations encountered	from	to
<u>Elmore Karcher</u>			
<u>P.O. Box</u>	<u>Surface clay</u>	<u>0</u>	<u>20</u>
<u>Picayune, Miss.</u>	<u>Surface sand</u>	<u>20</u>	<u>80</u>
(mailing address)			
WELL LOCATION:	<u>Blue clay</u>	<u>80</u>	<u>150</u>
sec. <u>24</u> T. <u>5</u> S. R. <u>17</u> W.	<u>Good sand</u>	<u>150</u>	<u>195</u>
<u>2 1/4</u> miles <u>S.</u> of <u>Carrriere</u>			
(distance) (direction) (nearest town)			
WELL PURPOSE: <u>Home</u>			
(home, irrigation, municipal, industrial)			
WELL COMPLETION DATA:			
(1) diameter (inches) <u>2"</u>			
(2) total depth (feet) <u>195</u>			
(3) static water level (feet) <u>84</u> below above top of ground.			
(4) casing <u>galv.</u> (material), (depth)			
<u>2"</u> (size) if telescope see back.			
(5) screen <u>5'</u> (length), (depth to top)			
<u>2"</u> (size), <u>S. Steel</u> (material)			
(6) pump <u>1</u> (HP), <u>650 gph</u> (yield gph)			
<u>electric</u> (type power)			
(7) electric log <u>no.</u> (yes or no)			
(organization running log)			
(8) how well bottom plugged <u>Sand</u>			
<u>Shark B.P.V.</u>			
DRILLERS REMARKS:			

CODED

APR 10 1973

If well telescopes please sketch and show depths.

GROUND LEVEL

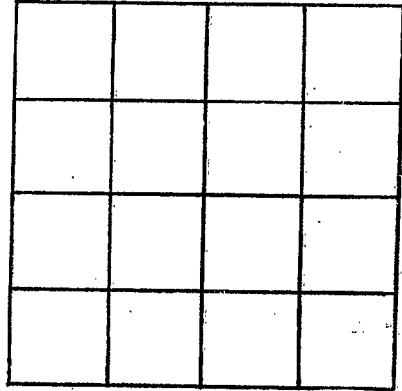

SECTION _____

Please indicate well location X.

ADDITIONAL INFORMATION

A series of horizontal lines providing space for additional information.

If more than one screen, show locations of each on sketch.