

PEARL RIVER
 U 85
 3-9-73

MISSISSIPPI
 BOARD OF WATER COMMISSIONERS
 416 North State Street
 Jackson, Mississippi 39201

CODED

WATER WELL DRILLERS LOG

3-9-73 date well completed 1973 Panton Well Serv firm name Pearl River county well located

LANDOWNER: J. A. Durafau

description of formations encountered from to

Picayune Miss-
 (mailing address)

Surface clay	0	25
sand	25	60
Blue clay	60	260
sand	260	300

WELL LOCATION:
 sec. 21 T. 5 S. R. 17 W.
 3 miles N. of Picayune
 (distance) (direction) (nearest town)

WELL PURPOSE: Home
 (home, irrigation, municipal, industrial)

WELL COMPLETION DATA:

- (1) diameter (inches) 2
- (2) total depth (feet) 300
- (3) static water level (feet) 20 below top of ground.
- (4) casing 621v 280 (material) (depth)
 2 (size) if telescope see back.
- (5) screen 10' 280 (length) (depth to top)
 2 S. steel (size) (material)
- (6) pump 1/2 7 (HP) (yield gpm)
 Elec (type power)
- (7) electric log NO (yes or no)

CODED


(organization running log)

(8) how well bottom plugged BW Valve

DRILLERS REMARKS:

If well telescopes please sketch and show depths.

GROUND LEVEL

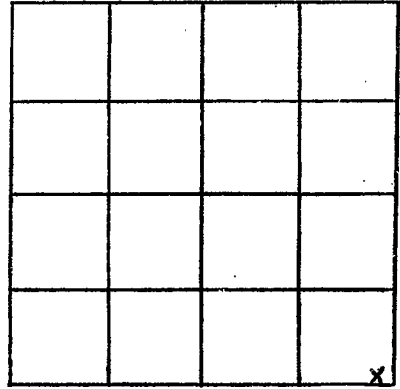

SECTION 21

Please indicate well location X.

ADDITIONAL INFORMATION

If more than one screen, show locations of each on sketch.