

PEARL RIVER
U 86
1-20-73

MISSISSIPPI
 BOARD OF WATER COMMISSIONERS
 416 North State Street
 Jackson, Mississippi 39201

WATER WELL DRILLERS LOG

CODED

1 ~~20~~ 1973 Earl Penford Water Well Pearl River
 date well completed firm name county well located

LANDOWNER:	description of formations encountered	from	to
<u>M. E. M. S Perights</u> <u>Picayune Miss.</u> (mailing address)			
WELL LOCATION: sec <u>32</u> T <u>5</u> N R <u>17</u> E <u>3</u> miles <u>W</u> of <u>Picayune</u> (distance) (direction) (nearest town)	<u>Co. white sd.</u>	<u>25</u>	<u>66</u>
WELL PURPOSE: <u>Home</u> (home, irrigation, municipal, industrial)	<u>Blue clay</u>	<u>66</u>	<u>128</u>
WELL COMPLETION DATA: (1) diameter (inches) <u>4 5/8</u>	<u>Coarse Blue sd.</u>	<u>128</u>	<u>176</u>
(2) total depth (feet) <u>746</u>	<u>Blue clay</u>	<u>176</u>	<u>270</u>
(3) static water level (feet) <u>21</u> below above top of ground.	<u>Coarse Blue sd.</u>	<u>270</u>	<u>340</u>
(4) casing <u>Galv.</u> (material), <u>726</u> ' (depth) <u>2"</u> (size) if telescope see back.	<u>Blue clay</u>	<u>340</u>	<u>526</u>
(5) screen <u>20'</u> (length), <u>726'</u> (depth to top) <u>2"</u> (size), <u>S.S.</u> (material)	<u>Coarse Blue sd.</u>	<u>526</u>	<u>576</u>
(6) pump <u>NO</u> (HP), (yield gpm) (type power)	<u>Blue clay</u>	<u>576</u>	<u>678</u>
(7) electric log <u>NO</u> (yes or no) (organization running log)	<u>Coarse Blue sd.</u>	<u>678</u>	<u>746</u>
(8) how well bottom plugged <u>Shoe</u>			


CODED

DRILLERS REMARKS:

MISSISSIPPI
 BOARD OF WATER COMMISSIONERS
 JACKSON, MISSISSIPPI

If well telescopes please sketch and show depths.

GROUND LEVEL

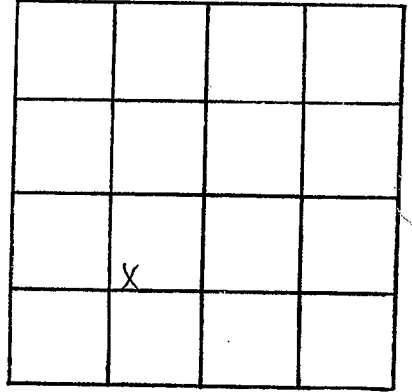

SECTION 32

Please indicate well location X.

ADDITIONAL INFORMATION

If more than one screen,
show locations of each on sketch.