

PEARL RIVER  
U 87  
10-25-72

MISSISSIPPI  
 BOARD OF WATER COMMISSIONERS  
 416 North State Street  
 Jackson, Mississippi 39201

WATER WELL DRILLERS LOG

10-25 1972 Earl Penton Water Well Serv. Pearl River  
 date well completed firm name county well located

**CODED**

LANDOWNER:	description of formations encountered	from	to
<u>Mr. Fred Roberts</u>	<u>Red &amp; white clay</u>	<u>0</u>	<u>14</u>
<u>Picayune miss.</u> (mailing address)	<u>white coarse sd.</u>	<u>14</u>	<u>22</u>
WELL LOCATION: sec. <u>28</u> T. <u>5</u> N. R. <u>17</u> E S. <u>4</u> miles <u>west</u> of <u>OSONA</u> (distance) (direction) (nearest town)	<u>Blue clay</u>	<u>22</u>	<u>230</u>
WELL PURPOSE: <u>Home</u> (home, irrigation, municipal, industrial)	<u>coarse gray sd. &amp; cr.</u>	<u>230</u>	<u>334</u>
WELL COMPLETION DATA: (1) diameter (inches) <u>4 5/8</u>	<u>Blue clay</u>	<u>334</u>	<u>524</u>
(2) total depth (feet) <u>650'</u>	<u>med. Blue sd.</u>	<u>524</u>	<u>620</u>
(3) static water level (feet) <u>23</u> below top of ground.	<u>Coarse Gray sd.</u>	<u>620</u>	<u>650</u>
(4) casing <u>Galv.</u> <u>630'</u> (material) (depth)			
<u>2"</u> If telescope see back. (size)			
(5) screen <u>20'</u> <u>630'</u> (length) (depth to top)			
<u>2"</u> <u>5.5</u> (size) (material)			
(6) pump <u>NO</u> (HP) (yield gpm)			
(type power)			
(7) electric log <u>NO</u> (yes or no)			
(organization running log)			
(8) how well bottom plugged <u>Shoe</u>			
DRILLERS REMARKS:			


**CODED**

MAR 27 1973

PEARL RIVER

If well telescopes please sketch and show depths.

GROUND LEVEL

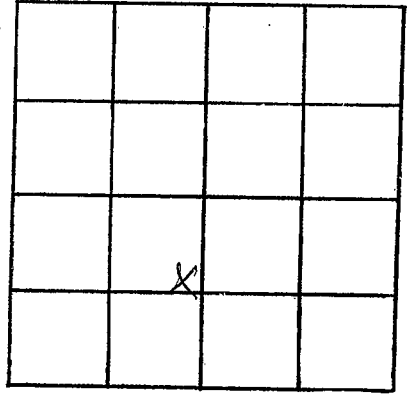

SECTION 28

Please indicate well location X.

ADDITIONAL INFORMATION

If more than one screen,  
show locations of each on sketch.