

PEARL RIVER
U 88
1-26-73

MISSISSIPPI
BOARD OF WATER COMMISSIONERS
416 North State Street
Jackson, Mississippi 39201

CODED

WATER WELL DRILLERS LOG


4/26 1973 Bird Petroleum & Son Pearl River
date well completed firm name county well located

LANDOWNER: <u>Cady Laundry</u>	description of formations encountered	from	to
R.T. 1 Bot (mailing address)	<u>Red shale</u> <u>Blue shale</u> <u>blue sand</u>	<u>0</u> <u>36</u> <u>221</u>	<u>36</u> <u>221</u> <u>258</u>
WELL LOCATION:			
sec. <u>10</u> T. <u>S</u> N. R. <u>17</u> E <u>3 1/4</u> miles <u>W</u> of <u>Carroll</u> (distance) (direction) (nearest town)			
WELL PURPOSE: <u>home</u> (home, irrigation, municipal, industrial)			
WELL COMPLETION DATA:			
(1) diameter (inches) <u>2 1/2</u>			
(2) total depth (feet) <u>258</u>			
(3) static water level (feet) <u>67</u> below above top of ground.			
(4) casing <u>gov.</u> <u>253</u> (material) (depth) <u>2 1/2</u> if telescope see back. (size)			
(5) screen <u>2x3 1/2</u> <u>263</u> (length) (depth to top)			
<u>2 1/2</u> <u>gov.</u> (size) (material)			
(6) pump <u>1</u> <u>460</u> (HP) (yield gpm)			
<u>elect.</u> (type power)			
(7) electric log (yes or no)			
(organization running log)			
(8) how well bottom plugged <u>hard</u>			
DRILLERS REMARKS:			

CODED

If well telescopes please sketch and show depths.

GROUND LEVEL

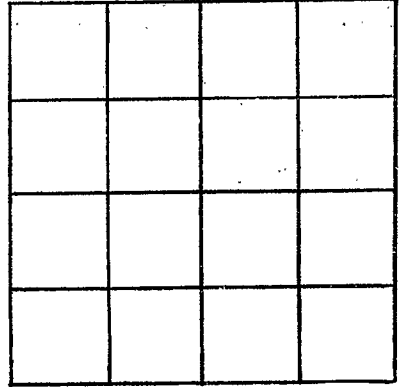

SECTION _____

Please indicate well location X.

ADDITIONAL INFORMATION

If more than one screen, show locations of each on sketch.