

Pearl River  
 U 91  
 6-10-73

MISSISSIPPI  
 BOARD OF WATER COMMISSIONERS  
 416 North State Street  
 Jackson, Mississippi 39201

**CODED**

WATER WELL DRILLERS LOG

June 10 1973 Lompkin Well Serv Pearl River  
 date well completed firm name county well located

LANDOWNER: Alton Smith  
 Row  
 PEARL RIVER, MISS.  
 (mailing address)

description of formations encountered	from	to
CLAY	0	48
SAND & GRAVEL	40	60
Blue Clay	60	230
Good Sand	230	279

WELL LOCATION:  
 sec. 32 T 5 N R 17 E  
2 miles N.W. of Pearl River  
 (distance) (direction) (nearest town)

WELL PURPOSE: Home  
 (home, irrigation, municipal, industrial)

WELL COMPLETION DATA:

(1) diameter (inches) 2"

(2) total depth (feet) 279

(3) static water level (feet) 15 below above top of ground.

(4) casing CAL, 273'  
 (material) (depth)  
2" if telescope see back.  
 (size)

(5) screen 5', 233'  
 (length) (depth to top)  
2", S.S.  
 (size) (material)

(6) pump 1/2, 15  
 (HP) (yield gpm)  
Elec.  
 (type power)

(7) electric log No  
 (yes or no)

(organization running log)

(8) how well bottom plugged SAND SHANK


**CODED**

DRILLERS REMARKS:

JUL 27 1973

If well telescopes please sketch and show depths.

GROUND LEVEL

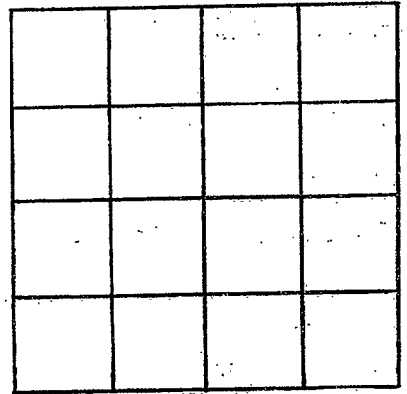

SECTION \_\_\_\_\_

Please indicate well location X.

ADDITIONAL INFORMATION

If more than one screen,  
show locations of each on sketch.