

U 95  
PEARL RIVER  
3-4-73

MISSISSIPPI  
BOARD OF WATER COMMISSIONERS  
416 North State Street  
Jackson, Mississippi 39201

COPIED

WATER WELL DRILLERS LOG

3/4 1973 Bud Pentecost Pearl River  
date well completed firm name county well located

LANDOWNER: Stanley Baker

R.T.L. Carrero  
Miss.  
(mailing address)

WELL LOCATION:  
sec. 10 T. 5 N R. 17 E  
2 1/2 miles W of Marion  
(distance) (direction) (nearest town)

WELL PURPOSE: home  
(home, irrigation, municipal, industrial)

- WELL COMPLETION DATA:
- (1) diameter (inches) 2"
  - (2) total depth (feet) 861
  - (3) static water level (feet) 11 1/2 <sup>below</sup> <sub>above</sub> top of ground.
  - (4) casing Steel, 840  
(material) (depth)  
if telescope see back.  
(size)
  - (5) screen 2x20, 840  
(length) (depth to top)  
2x20, stainless steel  
(size) (material)
  - (6) pump \_\_\_\_\_ (HP) \_\_\_\_\_ (yield gpm)  
(type power)
  - (7) electric log no  
(yes or no)  
(organization running log)
  - (8) how well bottom plugged clay  
steel


description of formations encountered	from	to
White shale	0	21
White sand	21	48
Blue shale	48	76
Blue sand	76	121
Blue shale	121	210
Blue sand	210	240
Blue shale	240	270
Blue sand	270	372
Blue shale	372	520
Blue sand	520	810
Blue sand	810	861

DRILLERS REMARKS:

10 100

If well telescopes please sketch and show depths.

GROUND LEVEL

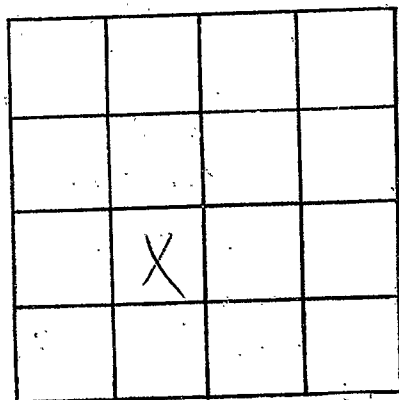

SECTION \_\_\_\_\_

Please indicate well location X.

ADDITIONAL INFORMATION

If more than one screen, show locations of each on sketch.