

P.R.
 U97
 9-19-73

MISSISSIPPI
 BOARD OF WATER COMMISSIONERS
 416 North State Street
 Jackson, Mississippi 39201

CODED

WATER WELL DRILLERS LOG

9-19 1973 SUTTER WELL WORKS Pearl River
 date well completed firm name county well located

LANDOWNER: R. B. Jones

Picayune, Miss.

(mailing address)

description of formations encountered

from

to

clay

0

24

red sand

24

40

clay

40

173

sand

173

195

WELL LOCATION:

sec. 5 T 5 R 17
 8 miles N of Picayune
 (distance) (direction) (nearest town)

WELL PURPOSE: farm use
 (home, irrigation, municipal, industrial)

WELL COMPLETION DATA:

- (1) diameter (inches) 2"
- (2) total depth (feet) 195'
- (3) static water level (feet) 97' below top of ground.
- (4) casing PVC pipe 190'
 (material) (depth)
 2" if telescope see back.
 (size)
- (5) screen 5' 190'
 (length) (depth to top)
 2" PVC
 (size) (material)
- (6) pump 1 10 gpm
 (HP) (yield gpm)
 elec.
 (type power)
- (7) electric log no
 (yes or no)
 (organization running log)

CODED

(8) how well bottom plugged B.P. Valve


DRILLERS REMARKS:

OCT 10 1973

MISS. DIV. OF
 WATER COMMISSIONERS

If well telescopes please sketch and show depths.

GROUND LEVEL

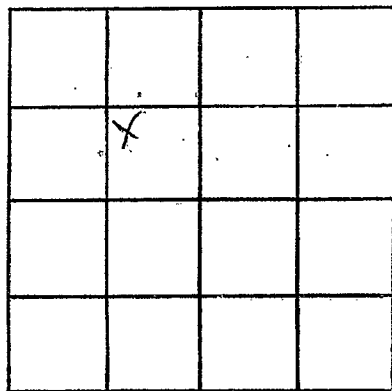

SECTION _____

Please indicate well location X.

ADDITIONAL INFORMATION

If more than one screen,
show locations of each on sketch.