

P.R.
 W98
 4-24-73

MISSISSIPPI
 BOARD OF WATER COMMISSIONERS
 416 North State Street
 Jackson, Mississippi 39201

CODED

WATER WELL DRILLERS LOG

Pearl River

4-24-73 Earl Benton water well sero.

date well completed

firm name

county well located

LANDOWNER:	description of formations encountered	from	to
Mr. Jimmy McBeth Carriere miss (mailing address)			
WELL LOCATION:	Fire white sd	18	45
sec. 4 T 5 N R 17 E	Blue clay	45	80
1 miles west of Carriere	Coarse Blue sd.	80	102
(distance) (direction) (nearest town)			
WELL PURPOSE: Home			
(home, irrigation, municipal, industrial)			
WELL COMPLETION DATA:			
(1) diameter (inches) 4.5			
(2) total depth (feet) 102			
(3) static water level (feet) 36 below above top of ground.			
(4) casing P.V.C. 97 (material) (depth)			
2" (size) If telescope see back.			
(5) screen 5' 97 (length) (depth to top)			
2 (size) P.V.C (material)			
(6) pump 1 420 H.P. (HP) (yield gpm)			
Elect (type power)			
(7) electric log NO (yes or no)			
(organization running log)			
(8) how well bottom plugged shoe			

CODED


DRILLERS REMARKS:

APR 24 1973

MISS. Bd. of WATER COMMISSIONERS

If well telescopes please sketch and show depths.

GROUND LEVEL

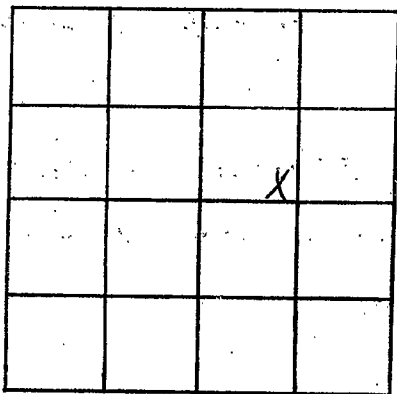

SECTION 4

Please indicate well location X.

ADDITIONAL INFORMATION

If more than one screen, show locations of each on sketch.