

P.R.
 U 99
 3-18-73

MISSISSIPPI
 BOARD OF WATER COMMISSIONERS
 416 North State Street
 Jackson, Mississippi 39201

CODED

WATER WELL DRILLERS LOG Pearl River

2-18-1973 Earl Penton water well serv.
 date well completed firm name county well located

LANDOWNER:
 Mrs. Margie Landry
 Rt. 1 Carriere Miss.
 (mailing address)

description of formations encountered	from	to
Red Clay	0	2.0
Coarse white sd.	2.0	2.5
white clay	2.5	142
Blue clay	142	250
C. Orsa Blue sd.	250	265

WELL LOCATION:
 sec. 5 T. 5 N R. 17 E
 4 miles west of Carriere
 (distance) (direction) (nearest town)

WELL PURPOSE: Home
 (home, irrigation, municipal, industrial)

WELL COMPLETION DATA:

(1) diameter (inches) 4.58

(2) total depth (feet) 265

(3) static water level (feet) 62 below above top of ground.

(4) casing Galv. 4.53 No. (material) (depth)

2 (size) If telescope see back.

(5) screen 5' 4.53 (length) (depth to top)

2 5.5 (size) (material)

(6) pump 1 450 G.P.M. (HP) (yield gpm)

Elect (type power)

(7) electric log NO (yes or no)

(organization running log)

(8) how well bottom plugged shoe

CODED


DRILLERS REMARKS:

NOV 2 1973

MISS. BD. OF WATER COMMISSIONERS

If well telescopes please sketch and show depths.

GROUND LEVEL

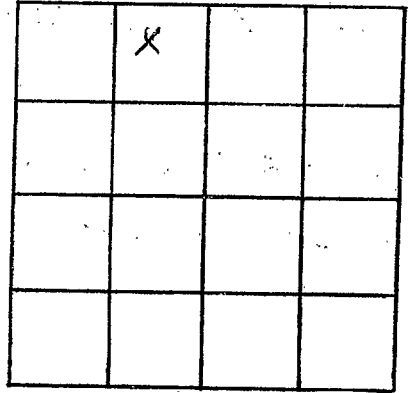

SECTION 5

Please indicate well location X.

ADDITIONAL INFORMATION

If more than one screen,
show locations of each on sketch.