

Pearl R.
 U 101
 4-5-74

MISSISSIPPI
 BOARD OF WATER COMMISSIONERS
 416 North State Street
 Jackson, Mississippi 39201

CODED

WATER WELL DRILLERS LOG

4-5-74 date well completed
 Bud Venters, Jr. firm name
 Pearl River county well located

LANDOWNER:
 Roland Downham
 Carriere, Miss.
 (mailing address)

description of formations encountered	from	to
Red Shale	0	10
White Sand Rock	10	72
Blue shale	72	110
Gray sand	110	150
Blue shale	150	224
Blue sand & rock	224	275
Blue shale	275	410
Gray sand	410	470

WELL LOCATION:
 sec. 10 T. 5 N. R. 17 E.
 2 miles W of Carriere
 (distance) (direction) (nearest town)

WELL PURPOSE: Home
 (home, irrigation, municipal, industrial)

WELL COMPLETION DATA:

- (1) diameter (inches) 2 1/2
- (2) total depth (feet) 470
- (3) static water level (feet) 146 above top of ground
- (4) casing Galv. 450 X 3 (material) (depth)
- if telescope see back.
- (5) screen 2 X 20, 450 (length) (depth to top)
 15 Stainless Steel (size) (material)
- (6) pump (HP) (yield gpm)
- (type power)
- (7) electric log NO (yes or no)
- (organization running log)

CODED

(8) how well bottom plugged
 Bud Venters


DRILLERS REMARKS:

DRILLERS
 MAY 21 1974

MISS. Bd. OF WATER COMM.

If well telescopes please sketch and show depths.

GROUND LEVEL

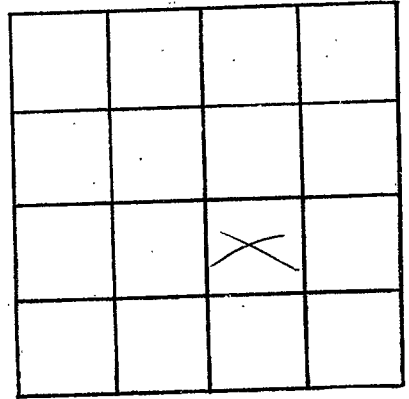

SECTION _____

Please indicate well location X.

ADDITIONAL INFORMATION

Lined area for additional information.

If more than one screen, show locations of each on sketch.