

Pearl River
 W 102,
 12-28-73

MISSISSIPPI
 BOARD OF WATER COMMISSIONERS
 416 North State Street
 Jackson, Mississippi 39201

CODED

WATER WELL DRILLERS LOG

12-28-73 19 Earl Penton water wells Pearl River
 date well completed firm name county well located

LANDOWNER:
Wilbur Daniels
Prayne, Miss.
 (mailing address)

description of formations encountered	from	to
<u>Red. Clay</u>	<u>0</u>	<u>20</u>
<u>Coarse white sd. con.</u>	<u>20</u>	<u>80</u>
<u>White Clay</u>	<u>80</u>	<u>120</u>
<u>Coars. yellow sd.</u>	<u>120</u>	<u>150</u>

WELL LOCATION:
 sec 28 T 5 N R 17 E
4 miles N. E. of Prayne
 (distance) (direction) (nearest town)

WELL PURPOSE: Home
 (home, irrigation, municipal, industrial)

WELL COMPLETION DATA:

(1) diameter (inches) 4 1/2

(2) total depth (feet) 150'

(3) static water level (feet) 50 below/above top of ground.

(4) casing P.V.C. 145'
 (material) (depth)
2" if telescope see back.
 (size)

(5) screen 5' 145'
 (length) (depth to top)
2" P.V.C.
 (size) (material)

(6) pump 1 400 Perky.
 (HP) (yield gpm)
Elect.
 (type power)

(7) electric log NO
 (yes or no)

(8) how well bottom plugged Shoe


CODED

DRILLERS REMARKS:

APR 20 1974
 MISS. Bd. of Water Comm.

If well telescopes please sketch and show depths.

GROUND LEVEL

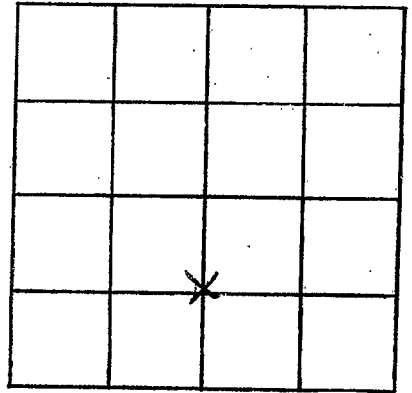

SECTION 28

Please indicate well location X.

ADDITIONAL INFORMATION

If more than one screen,
show locations of each on sketch.