

P. R.
U. 104
5.9-74

MISSISSIPPI
BOARD OF WATER COMMISSIONERS
416 North State Street
Jackson, Mississippi 39201

CODED

WATER WELL DRILLERS LOG

5-9 date well completed
1974 Periton Well Serv firm name
Pearl River county well located

LANDOWNER: William Davis

Rt. 4

Picayune Miss.
(mailing address)

WELL LOCATION:

sec. 28 T. 5 N. R. 17 E.
S W
2 miles N.W. of Picayune
(distance) (direction) (nearest town)

WELL PURPOSE: Home
(home, irrigation, municipal, industrial)

WELL COMPLETION DATA:

- (1) diameter (inches) 2
- (2) total depth (feet) 1040
- (3) static water level (feet) flow above top of ground.
- (4) casing Galv 1020
(material) (depth)
2 if telescope see back.
(size)
- (5) screen 20' 1020
(length) (depth to top)
2 S. Steel
(size) (material)
- (6) pump - -
(HP) (yield gpm)
-
(type power)
- (7) electric log No
(yes or no)
- (organization running log)
- (8) how well bottom plugged B.W. Valve

description of formations encountered

from to

Surface Clay	0	25
Sand	25	53
Blue Clay	53	240
Sand	240	318
Blue Clay	318	520
Sand	520	640
Blue Clay	640	780
Sand	780	827
Blue Clay	827	940
Sand	940	1040


DRILLERS REMARKS:

JUN 19 1974

MISS. BD. OF WATER COMMISSIONERS

If well telescopes please sketch and show depths.

GROUND LEVEL

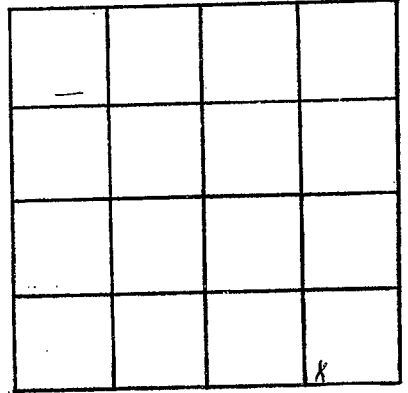

SECTION 28

Please indicate well location X.

ADDITIONAL INFORMATION

If more than one screen, show locations of each on sketch.