

Pearl River
 U 105
 6-13-74

MISSISSIPPI
 BOARD OF WATER COMMISSIONERS
 416 North State Street
 Jackson, Mississippi 39201

CODED

WATER WELL DRILLERS LOG

June 13 1974 Lumpkin Well Ser. Pearl River
 date well completed firm name county well located

LANDOWNER Mr. Loran Glouse

Description of formations encountered

from to

Pearl River, Miss.
 (mailing address)

Clay	0	35
Sand	35	105
Clay	105	250
Sand	250	315

WELL LOCATION:

sec. 26 T 5 N R 17 E
 4 miles (distance) S of Pearl River (nearest town)

WELL PURPOSE: Home
 (home, irrigation, municipal, industrial)

WELL COMPLETION DATA:

CODED

- diameter (inches) 2"
- total depth (feet) 315
- static water level (feet) 80 below top of ground.
- casing P.V.C. 310 (material) (depth)
 2" (size) if telescope see back.
- screen 5' (length) 310' (depth to top)
 2" (size) P.V.C. (material)
- pump 1 (HP) 500 P.h. (yield gpm)
 Elec. (type power)
- electric log No (yes or no)
 No (organization running log)
- how well bottom plugged Sand Shovel


DRILLERS REMARKS:

DECLINING

MIC - 8 1974

If well telescopes please sketch and show depths.

GROUND LEVEL

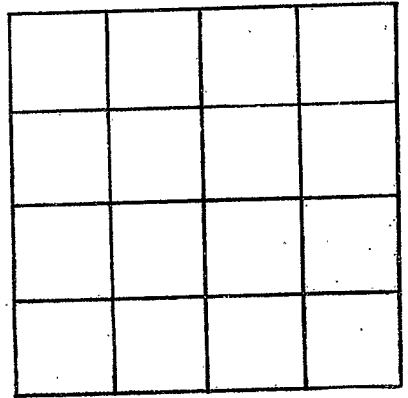

SECTION _____

Please indicate well location X.

ADDITIONAL INFORMATION

If more than one screen,
show locations of each on sketch.