

MISSISSIPPI
BOARD OF WATER COMMISSIONERS
416 North State Street
Jackson, Mississippi 39201

WATER WELL DRILLERS LOG

CODED

Pearl R.
U 106
1-6-75

1-6-75 date well completed
Bud Kuntz & Son firm name
Pearl River county well located

LANDOWNER: J.W. Spivey
Rt. 1,
Carnie, Miss.
(mailing address)

WELL LOCATION:
sec. 9 T 5 N R 17 E
2 1/2 miles W of Carnie
(distance) (direction) (nearest town)

WELL PURPOSE: Home
(home, irrigation, municipal, industrial)

WELL COMPLETION DATA:
(1) diameter (inches) 2 in
(2) total depth (feet) 740
(3) static water level (feet) 9 1/2 below above top of ground.
(4) casing 4 in 740 (material) (depth)
(size) If telescope see back.
(5) screen 2x20 720 (length) (depth to top)
2x20 S.S. Screen 1010 (size) (material)
(6) pump flo (HP) (yield gpm)
(type power)
(7) electric log no (yes or no)
(organization running log)
(8) how well bottom plugged Sand Shank

description of formations encountered	from	to
Red Sand	0	18
White Sand	18	24
Blue Shale	24	25
Blue Sand fine	25	150
Blue Shale	150	235
Blue Sand fine	235	275
Blue Shale	275	350
Blue Sand Good	350	420
Blue Shale	420	480
Blue Sand fine	480	530
Blue Shale	530	600
Blue Sand & Rock	600	760


CODED

RECEIVED
APR - 3 1975

DRILLERS REMARKS:
log at 220 ft.

If well telescopes please sketch and show depths.

GROUND LEVEL

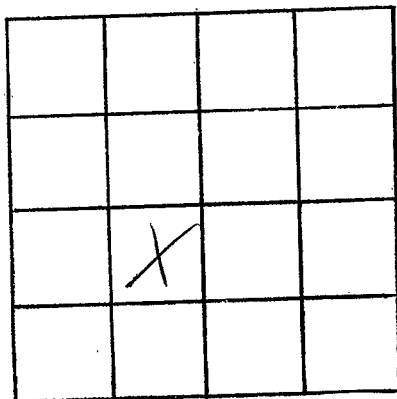

SECTION _____

Please indicate well location X.

ADDITIONAL INFORMATION

If more than one screen,
show locations of each on sketch.