

Pearl R.  
 W107  
 3-20-75

MISSISSIPPI  
 BOARD OF WATER COMMISSIONERS  
 416 North State Street  
 Jackson, Mississippi 39201

CODED

WATER WELL DRILLERS LOG

3-20 1975 Penton Well Serv Pearl River  
 date well completed firm name county well located

LANDOWNER: Dale McCarty  
Picayune Miss  
 (mailing address)

WELL LOCATION:  
 sec. 35 T 5 S R 17 W  
0 miles North of Richardson  
 (distance) (direction) (nearest town)


WELL PURPOSE: Home  
 (home, irrigation, municipal, industrial)

WELL COMPLETION DATA:

- (1) diameter (inches) 2
- (2) total depth (feet) 1156
- (3) static water level (feet) Flow <sup>below</sup> <sub>above</sub> top of ground.
- (4) casing Blck, 1136, 131  
 (material) (depth)
- 2 If telescope see back.  
 (size)
- (5) screen 20, 1136  
 (length) (depth to top)
- 2, S. Steel  
 (size) (material)
- (6) pump ✓ ✓  
 (HP) (yield gpm)
- ✓  
 (type power)
- (7) electric log No  
 (yes or no)
- (organization running log)
- (8) how well bottom plugged Bl. Valve

description of formations encountered	from	to
Surface Clay	0	25
Sand	25	50
Blue Clay	50	260
Sand	260	340
Blue Clay	340	440
Sand	440	480
Blue Clay	480	560
Sand	560	650
Blue Clay	650	900
Sand	900	980
Blue Clay	980	1080
Sand	1080	1156

CODED

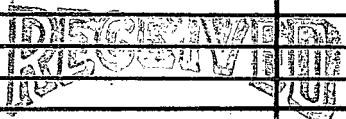


APR 10 1975

DRILLERS REMARKS: 16 lbs  
Pressure

If well telescopes please sketch and show depths.

GROUND LEVEL

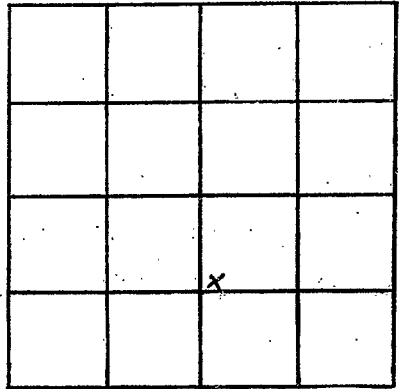

SECTION 35

Please indicate well location X.

ADDITIONAL INFORMATION

If more than one screen, show locations of each on sketch.