

Pearl River
 71 110
 6-14-75

MISSISSIPPI
 BOARD OF WATER COMMISSIONERS
 416 North State Street
 Jackson, Mississippi 39201

CODED

WATER WELL DRILLERS LOG

6-14 1975 Lumphkin Well Ser - Pearl River
 date well completed firm name county well located

LANDOWNER:
 Mr. Connis Smith
 Pecayune, Mo.
 (mailing address)

WELL LOCATION:
 sec. 29 T. 5 N. R. 13 E. 13U
 5 S. 1 W.
 6 miles N/W of Pecayune
 (distance) (direction) (nearest town)

WELL PURPOSE: Home
 (home, irrigation, municipal, industrial)

WELL COMPLETION DATA:
 (1) diameter (inches) 2"
 (2) total depth (feet) 744'
 (3) static water level (feet) 10" below top of ground.
 (4) casing P.V.C. 724' (material) (depth)
 2" (size) if telescope see back.
 (5) screen 20' length, 724' depth to top
 2" P.V.C. (size) (material)
 (6) pump No 30 (HP) (yield gpm)
 No (type power)
 (7) electric log No (yes or no)
 No (organization running log)
 (8) how well bottom plugged Sand shell


description of formations encountered	from to	
Clay	0	20
Sand	20	75
Clay	75	85
Sand	85	95
Clay	95	125
Sand	125	150
Clay	150	240
Sand	240	360
Clay	360	440
Sand	440	465
Clay	465	535
Sand	535	560
Clay	560	630
Sand	630	744

RECEIVED
 JUL 14 1975

DRILLERS REMARKS:

If well telescopes please sketch and show depths.

GROUND LEVEL

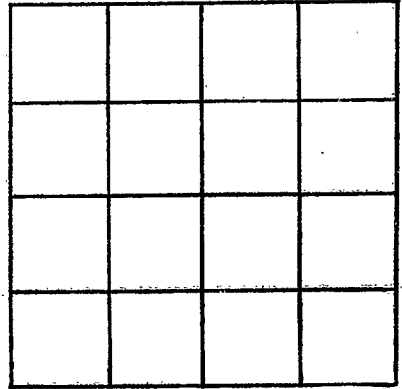

SECTION _____

Please indicate well location X.

ADDITIONAL INFORMATION

If more than one screen,
show locations of each on sketch.