

Pearl River
 U 112
 8-67

MISSISSIPPI
 BOARD OF WATER COMMISSIONERS
 416 North State Street
 Jackson, Mississippi 39201

WATER WELL DRILLERS LOG CODED

8-19-67 19 Neil Sampson Well Pearl River
 date well completed Delq. firm name county well located

LANDOWNER: C.G. Yates
 Picayune, Miss.

description of formations encountered	from	to
Clay	0	25
Sand	25	115
Clay	115	230
Sand	230	390
Clay	390	460
Sand	460	500
Clay	500	580
Sand	580	625
Clay	625	700
Sand	700	757

(mailing address)

WELL LOCATION:
 sec 32 T 5 S R 17 E
 2 miles NW of Picayune
 (distance) (direction) (nearest town)


WELL PURPOSE: home
 (home, irrigation, municipal, industrial)

WELL COMPLETION DATA:

- (1) diameter (inches) 2"
- (2) total depth (feet) 757'
- (3) static water level (feet) 746' below top of ground.
- (4) casing 2" steel pipe 756' (material) (depth)
- (size) if telescope see back.
- (5) screen 24" (length) (depth to top)
- 2" (size) (material)
- (6) pump 60 gal per min (HP) (yield gpm)
- (type power)
- (7) electric log yes (yes or no)
- (organization running log)
- (8) how well bottom plugged Johnson
 back pressure valve

DRILLERS REMARKS:

CODED

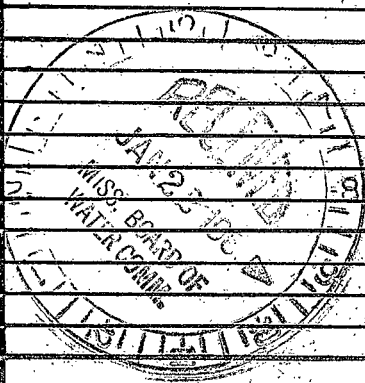

If well telescopes please sketch and show depths.

GROUND LEVEL

		7	

SECTION 32

Please indicate well location X.

ADDITIONAL INFORMATION

Highway 43

If more than one screen, show locations of each on sketch.