

Pearl River
U 117
9-24-75

MISSISSIPPI
 BOARD OF WATER COMMISSIONERS
 416 North State Street
 Jackson, Mississippi 39201

CODED

WATER WELL DRILLERS LOG

9-24
 date well completed:

1975 Penton Well Serv
 firm name

Pearl River
 county well located

LANDOWNER: Eugene Watkins

198 Boley Dr.
Picayune - MS
 (mailing address)

description of formations encountered

from to

Surface Clay	0	30
Sand	30	75
Blue Clay	75	240
Sand	240	340
Blue Clay	340	620
Sand	620	660

WELL LOCATION:

sec. 20 T 5 N R 17 E 13Y
 S W
4 miles NW of Picayune
 (distance) (direction) (nearest town)

WELL PURPOSE: Home
 (home, irrigation, municipal, industrial)

WELL COMPLETION DATA:

- (1) diameter (inches) 2
- (2) total depth (feet) 660
- (3) static water level (feet) 20 below
 top of ground. above
- (4) casing Galv 650
 (material) (depth)
2
 (size) If telescope see back.
- (5) screen 10' 650
 (length) (depth to top)
2 St. Steel
 (size) (material)
- (6) pump 1 17
 (HP) (yield gpm)
Elec
 (type power)
- (7) electric log NO
 (yes or no)

(organization running log)

(8) how well bottom plugged B.W. Value

DRILLERS REMARKS:


CODED

REGISTERED
 1975
 10/13/75
 1071

MISS. Bd. OF WATER COMMISSIONERS

If well telescopes please sketch and show depths.

GROUND LEVEL

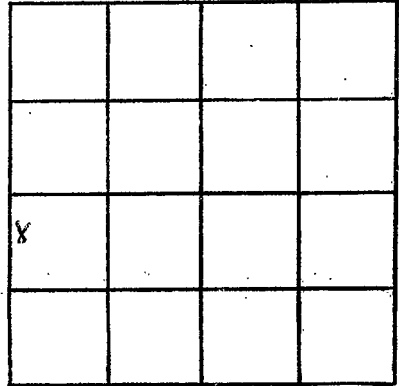

SECTION 20

Please indicate well location X.

ADDITIONAL INFORMATION

If more than one screen, show locations of each on sketch.