

Pearl R.
 W 119
 12-1-76

MISSISSIPPI
 BOARD OF WATER COMMISSIONERS
 416 North State Street
 Jackson, Mississippi 39201

CODED

WATER WELL DRILLERS LOG

12-1 1976 Bud Pentecost Pearl River
 date well completed firm name county well located

LANDOWNER: J.R. Skipworth

Route 1, Box 34
 Carriere, Miss. 39426
 (mailing address)

description of formations encountered	from	to
White shale	0	15
White sand	15	135
Blue shale	135	585
Gray sand	585	630
Blue shale	630	785
Gray sand	785	861

WELL LOCATION:
 sec. 9 T 19 N R 17 W
 2 1/2 miles W of Carriere
 (distance) (direction) (nearest town)

WELL PURPOSE: Home
 (home, irrigation, municipal, industrial)

WELL COMPLETION DATA:

- (1) diameter (inches) 2 in
- (2) total depth (feet) 861
- (3) static water level (feet) 9 ft below top of ground
- (4) casing Galv. 841 ft
 (material) (depth)
- (5) screen 2x20, 841
 (length) (depth to top)
 No 12, S. Steel
 (size) (material)
- (6) pump 9 1/2 hp.
 (HP) (yield gpm)
 flo
 (type power)
- (7) electric log (yes or no)
- (organization running log)
- (8) how well bottom plugged?
 Sand Shale

CODED


RECEIVED
 APR 15 1977

DRILLERS REMARKS:

MISS. BD. OF WATER

If well telescopes please sketch and show depths.

GROUND LEVEL

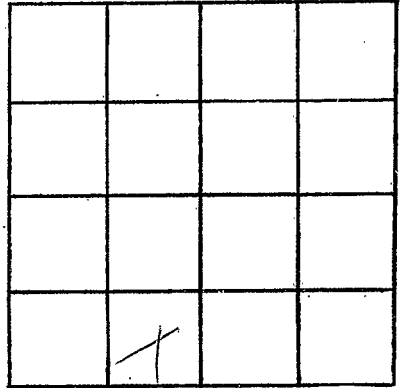

SECTION _____

Please indicate well location X.

ADDITIONAL INFORMATION

If more than one screen,
show locations of each on sketch.