

Peavil R.  
 U 120  
 7-14-78

MISSISSIPPI  
 BOARD OF WATER COMMISSIONERS  
 416 North State Street  
 Jackson, Mississippi 39201

WATER WELL DRILLERS LOG

7-14 date well completed      1978 Bud Penton & Son firm name      Pearl River county well located

LANDOWNER:  
 Charles Smith  
 Ocean Springs, Mo.  
 (mailing address)

description of formations encountered	from	to
Red Shale	0	30
White Sand	30	75
Blue Shale	75	175
Blue Sand	175	190
Blue Shale	190	510
Grey Sand	510	639

WELL LOCATION:  
 sec 23 T 5 N R 17 E  
 3 miles S of Ocean Springs  
 (distance) (direction) (nearest town)


WELL PURPOSE: Home  
 (home, irrigation, municipal, industrial)

WELL COMPLETION DATA:

(1) diameter (inches) 2 in  
 (2) total depth (feet) 639  
 (3) static water level (feet) 11 below above top of ground.  
 (4) casing PVC 639 (material) (depth)  
 (size) if telescope see back.  
 (5) screen 2x30 609 (length) (depth to top)  
 12 PVC (size) (material)  
 (6) pump NO (HP) (yield gpm)  
 flo (type power)  
 (7) electric log (yes or no)  
 (organization running log)

(8) how well bottom plugged Sand Shale


DRILLERS REMARKS:

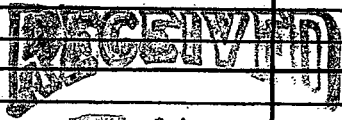

JUL 31 1978

If well telescopes please sketch and show depths.

GROUND LEVEL

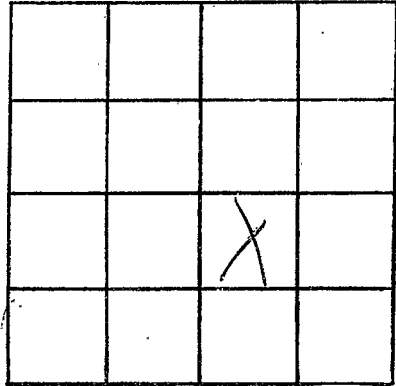

SECTION \_\_\_\_\_

Please indicate well location X.

ADDITIONAL INFORMATION

If more than one screen,  
show locations of each on sketch.