

Pearl River
 U 121
 12/11/78

MISSISSIPPI
 BOARD OF WATER COMMISSIONERS
 416 North State Street
 Jackson, Mississippi 39201

CODED

WATER WELL DRILLERS LOG

12/11 date well completed 1978 firm name Red Barton & Son Pearl River county well located

LANDOWNER: Turner
Desett R.T. 2
hwy
Wagon Miss.
 (mailing address)

WELL LOCATION:
 sec. 33 T. 5 N. R. 18 E.
 (distance) (direction) (nearest town)

WELL PURPOSE: none
 (home, irrigation, municipal, industrial)

WELL COMPLETION DATA:
 (1) diameter (inches) 2'
 (2) total depth (feet) 1245
 (3) static water level (feet) 14 below/above top of ground.
 (4) casing galv. (material) 1245 (depth)
 (size) if telescope see back.
 (5) screen 2x20 (length) 1276 (depth to top)
12 (size) steel (material)
 (6) pump no (HP) (yield gpm)
 (type power)
 (7) electric log no (yes or no)
 (organization running log)


(8) how well bottom plugged
sand
 DRILLERS REMARKS:

description of formations encountered	from	to
Red shale	0	43
white sand	43	90
Blue shale	90	266
Blue sand	266	337
Blue shale	337	726
Blue sand	726	764
Blue shale	764	960
gray sand	960	1160
Blue shale	1160	1200
gray sand	1200	1245

Miss. Board of Water Comm.
 FEB 26 1979
 RECORDED

If well telescopes please sketch and show depths.

GROUND LEVEL

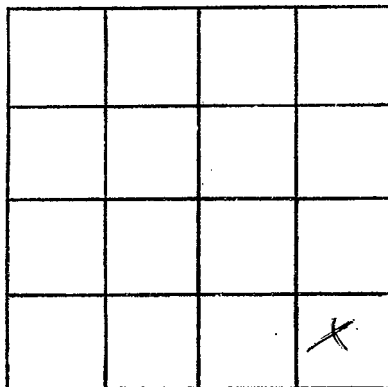

SECTION _____

Please indicate well location X.

ADDITIONAL INFORMATION

If more than one screen,
show locations of each on sketch.