

MISSISSIPPI DEPARTMENT OF NATURAL RESOURCES

Bureau of Land and Water Resources

Southport Mall

P.O. Box 10631

Jackson, Mississippi 39209

371

WATER WELL DRILLERS LOG

BUD PENTON & SON  
WATER WELL SERVICE

ROUTE 4 BOX 407  
CARRIERE, MS 39426  
PHONE 798-5324

*Pearl River*  
county well located

PEARL RIVER

U 126

6-3-82

6/3

BUD PENTON & SON  
WATER WELL SERVICE  
ROUTE 4 BOX 407  
CARRIERE, MS 39426  
PHONE 798-5324

date well completed

19 82

BUD PENTON & SON  
WATER WELL SERVICE  
ROUTE 4 BOX 407  
CARRIERE, MS 39426  
PHONE 798-5324

LANDOWNER: *James Williams*

*R.T. C. Pinyone*

(mailing address)

WELL LOCATION:

sec 28 T 5 N R 17 E  
6 miles W of Pinyone  
(distance) (direction) (nearest town)

WELL PURPOSE: *home*  
(home, irrigation, municipal, industrial)

WELL COMPLETION DATA:

- (1) diameter (inches) 2"
- (2) total depth (feet) 545
- (3) static water level (feet) 12 below above top of ground.
- (4) casing PCC, 5-9.5  
(material) (depth)  
Elevation: 62 feet  
0894225303504  
If telescope see back.  
(size)
- (5) screen 2x20, 5-7.5  
(length) (depth to top)  
15, PCC  
(size) (material)
- (6) pump NO  
(HP) (yield gpm)  
(type power)
- (7) electric log NO  
(yes or no)

(organization running log)

(8) how well bottom plugged *hard*

DRILLERS REMARKS: *no pump furnished*


description of formations encountered	from	to
<i>white shale</i>	<i>0</i>	<i>15</i>
<i>white sand</i>	<i>15</i>	<i>42</i>
<i>blue shale</i>	<i>42</i>	<i>245</i>
<i>blue sand</i>	<i>245</i>	<i>336</i>
<i>blue shale</i>	<i>336</i>	<i>378</i>
<i>blue sand</i>	<i>378</i>	<i>399</i>
<i>blue shale</i>	<i>399</i>	<i>484</i>
<i>gray sand</i>	<i>484</i>	<i>595</i>

DEPT. OF NATURAL RESOURCES  
BUREAU OF LAND & WATER RESOURCES

JUL - 1 1982  
RECEIVED

If well telescopes please sketch and show depths.

GROUND LEVEL

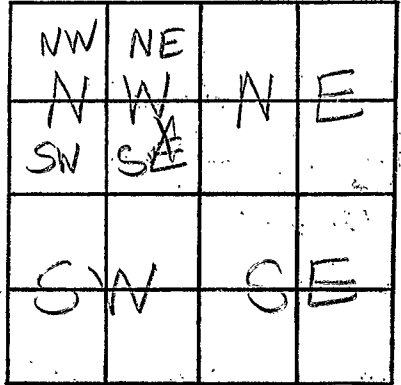

SECTION \_\_\_\_\_

Please indicate well location X.

ADDITIONAL INFORMATION

If more than one screen,  
show locations of each on sketch.